


# T3S. R1E. WM.

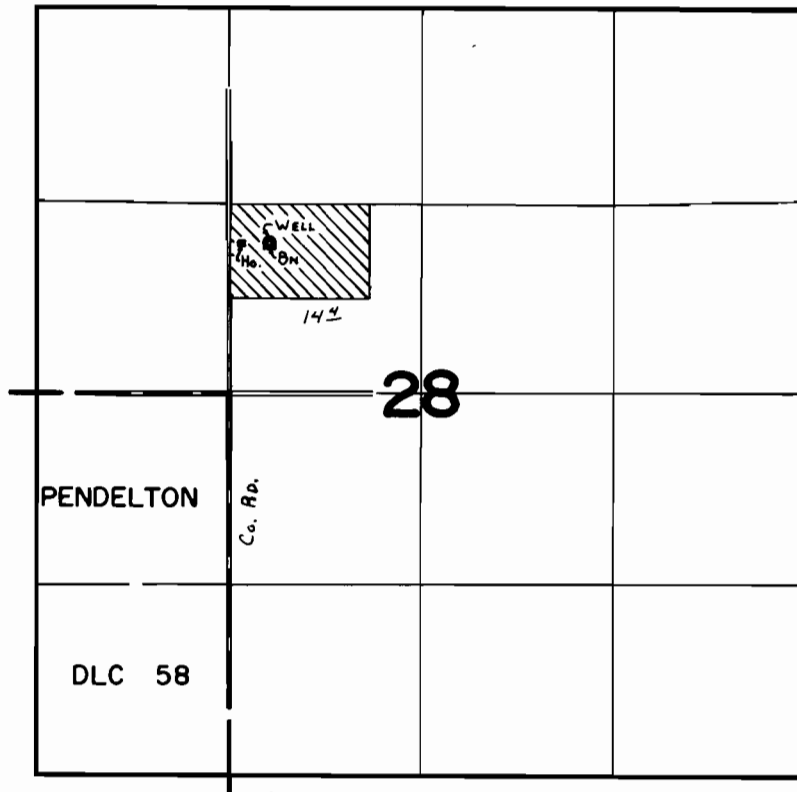

WELL Loc: 1040' N. & 280' E. fr. N.E. Cor. PENDELTON DLC 58.

## FINAL PROOF SURVEY UNDER

Application No. G-7665 Permit No. G-7252  
IN NAME OF

LEO J. GARRE

Surveyed JUNE 6 1978, by C. L. HUGHES.