


T2S. R2E. WM.

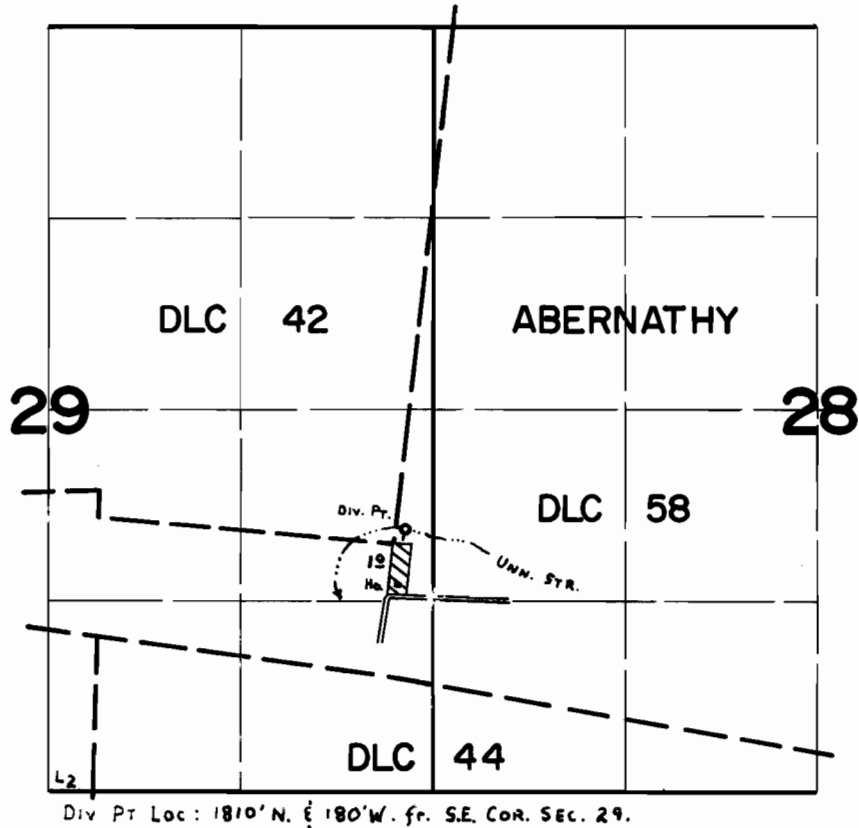

FINAL PROOF SURVEY UNDER

Application No. 44586 Permit No. 33373
IN NAME OF

JOHN G. SUNDSTROM

Surveyed SEPT. 28 1978, by C. L. HUGHES