


T3S. R2E. WM.

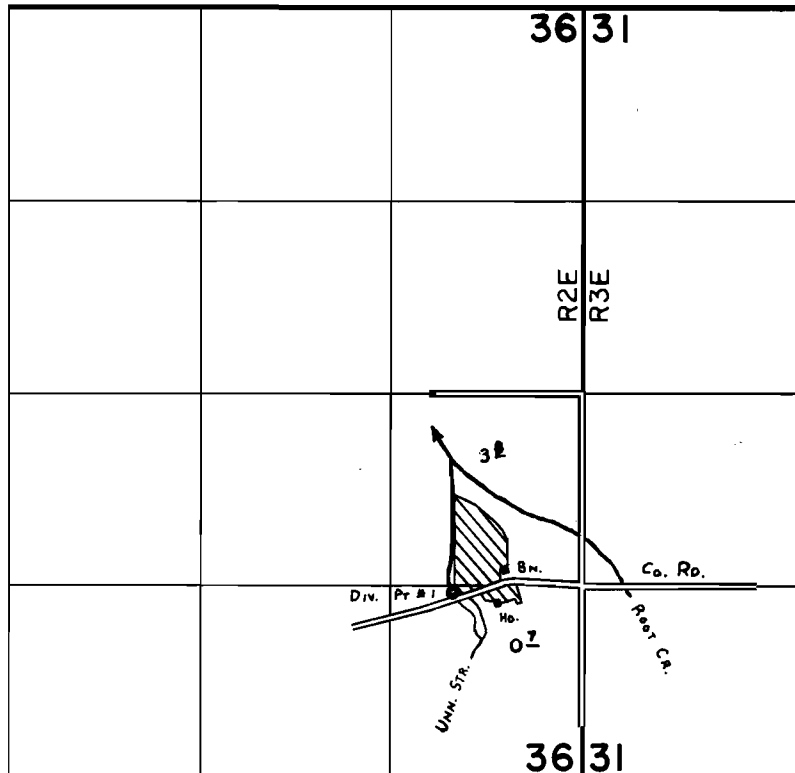

Div. Pts. Loc: N1-1270' N. & 890' W.

FROM S.E. COR. SEC. 36.

FINAL PROOF SURVEY
UNDER

Application No. 38670 Permit No. 28878
IN NAME OF

FRANK O. WILLE, JR.

Surveyed AUG. 2, 1978, by C. L. HUGHES