


T.3S.R.3E.W.M.

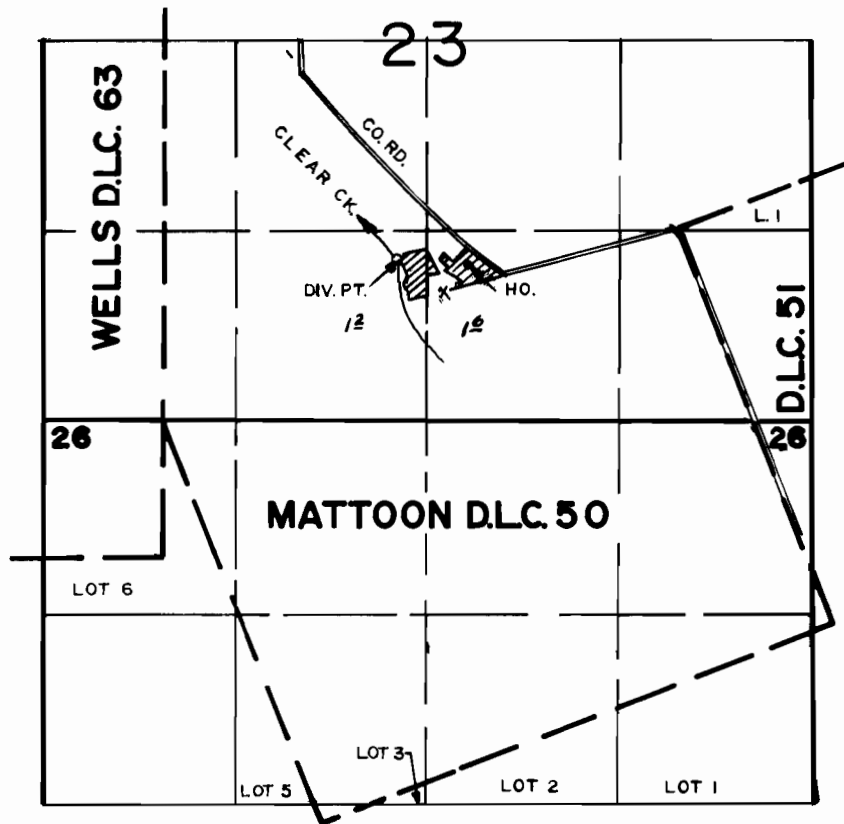

DIV. PT. LOC.: 200'S & 1950'W. FROM NW. COR. BROWN D.L.C. 51

FINAL PROOF SURVEY UNDER

Application No. 51615..... Permit No. 38929.....
IN NAME OF

MR. & MRS. STANTON L. COLEMAN.....

Surveyed MAR. 28... 1980, by R.G. MUCKEN.....