


T.16S. R.19E., W.M.

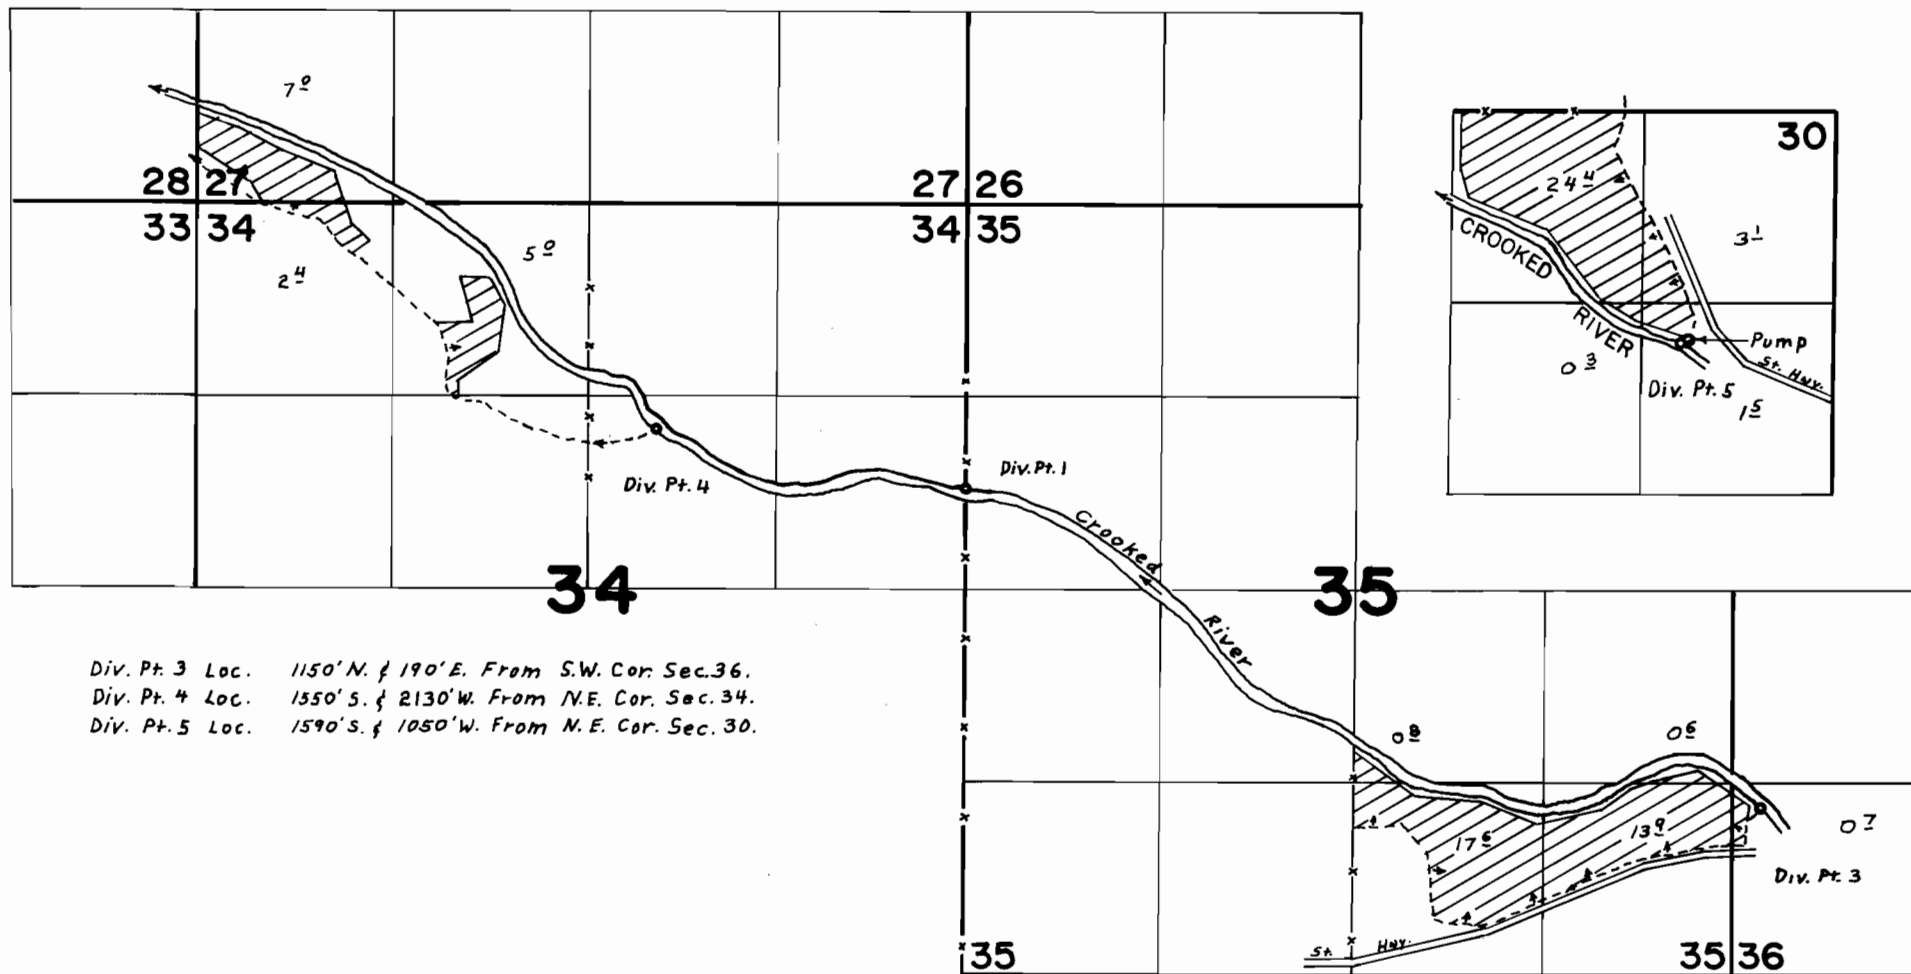

FINAL PROOF SURVEY UNDER

Application No. 39926 Permit No. 29717
IN NAME OF

ASPEN VALLEY RANCH

Surveyed JUNE 28 1978 by J.S.DONALDSON