


T. 29 S., R. 7 W., W.M.

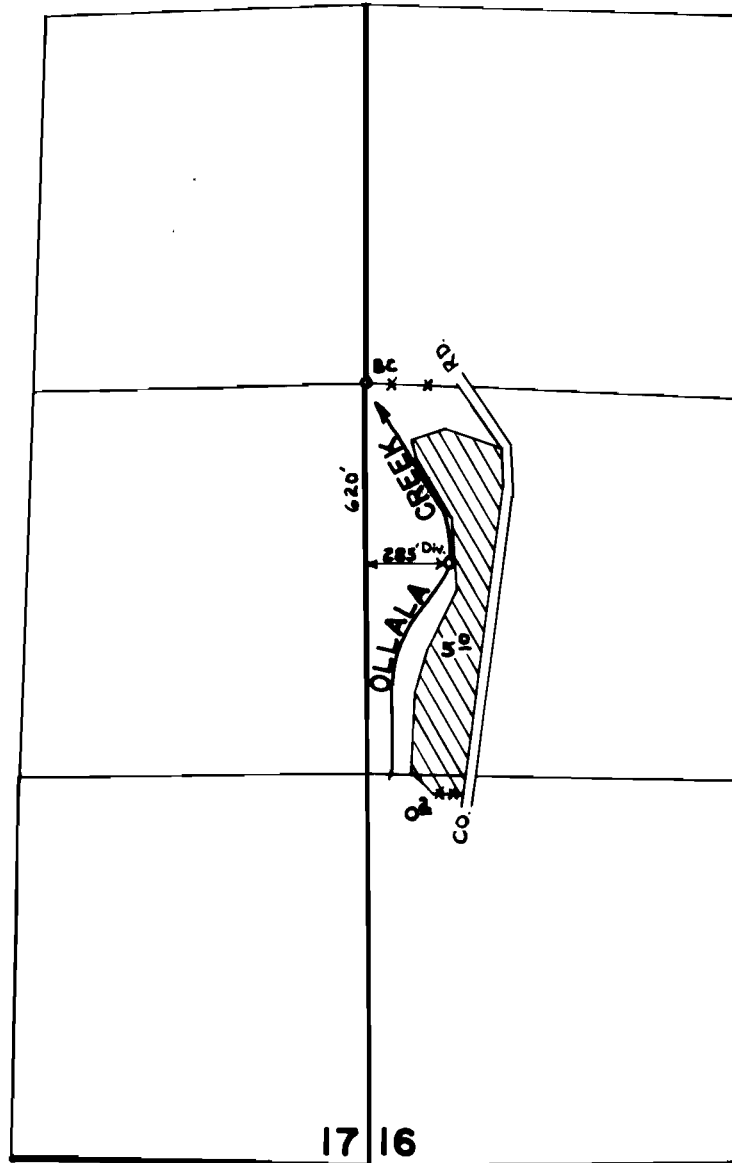

Scale: 1" = 660'

FINAL PROOF SURVEY
UNDER

Application No. 50721... Permit No. 38311.....
IN NAME OF

.....**DALE R. HOLCOMB**.....

Surveyed **MAY 22, 1978**, by **D.W. SPARKS**.....