


T. 13S. R. 30E. W. M.

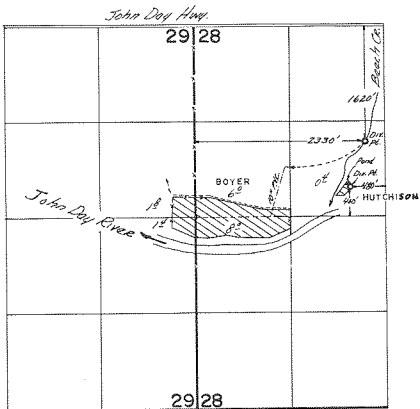

**FINAL PROOF SURVEY**  
UNDER

Application No. **38677**. Permit No. **28815**.....

IN NAME OF

*Donald & Elsa Boyer*  
..... *Robert & Wilda Hutchison* .....

Surveyed ~~Sept.~~ **Sept. 13**, 19**79**, by **S. C. BROWN**.....