


56473 32619

RECEIVED

FEB 8 1982

WATER RESOURCES DEPT
SALAS, OREGON

T. 13S. R. 30E. W.M.

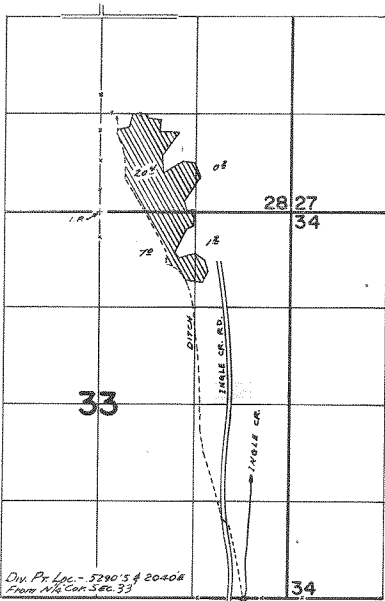

FINAL PROOF SURVEY
UNDER

Application No. 43629... Permit No. 32619...
IN NAME OF

DENNIS LEMONS

Surveyed June... 12, 1978, by J.S. Donaldson...

PT-1978-0-500