



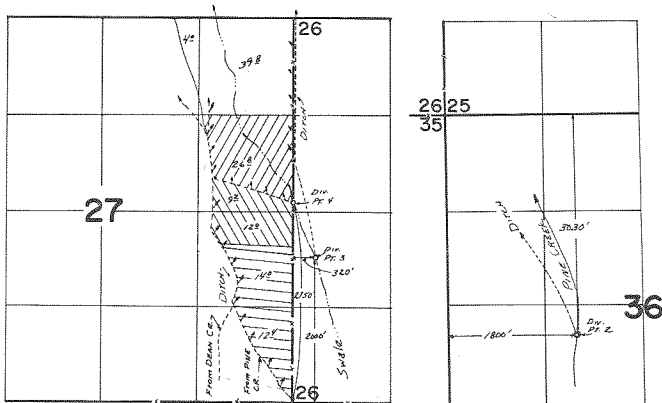

## T. 13S. R. 32E. W.M.

 

**FINAL PROOF SURVEY**  
UNDER

-  - SUPPL. FROM SWALE.
-  - SUPPL. FROM PINE CR.
-  - PRIMARY FROM PINE CR.

Application No. 45896... Permit No. 34271....  
IN NAME OF

.....CLYDE HOLIDAY.....

Surveyed Aug., 25, 1978., by J.S. Donaldson.....