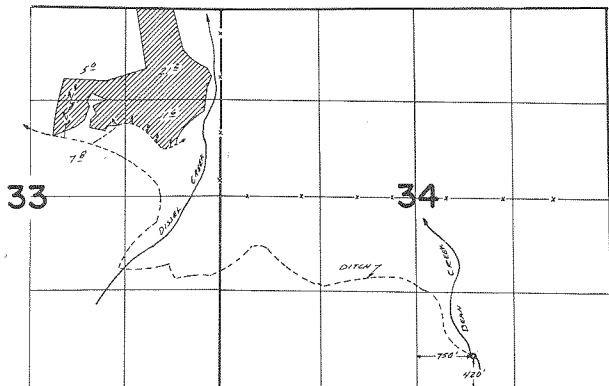


T. 13S. R. 32E. W.M.

**FINAL PROOF SURVEY**
UNDERApplication No. 45897... Permit No. 34272..
IN NAME OF

CLYDE HOLIDAY

Surveyed Aug. 26 1978., by J.S.Donaldson...