


38175
C-50676

T. 15S. R. 31 & 32E. W.M.

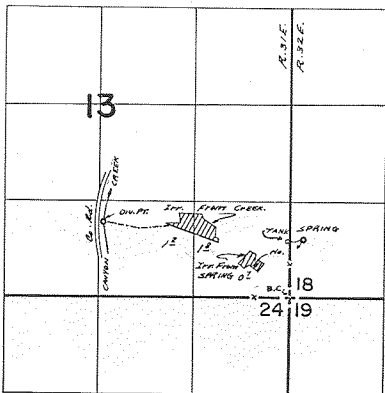

DIV. PT. @ CREEK LOC. - 1000' N & 2500' W } FROM SE. COR. SEC. 13
SPRING LOC. - - 800' N & 240' E }

FINAL PROOF SURVEY UNDER

Application No. 50563. Permit No. 38175...
IN NAME OF

.....CLIFF BELCHER JR.....

Surveyed Aug. 26 1978, by J.S. Donaldson...