
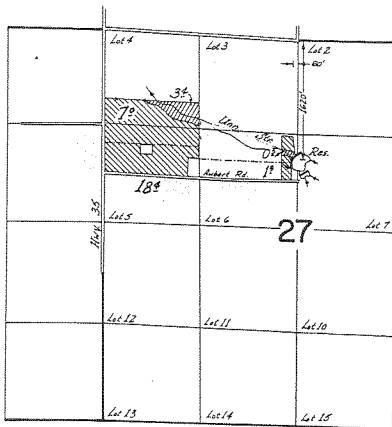



T.I.N., R.I.O.E., W.M.

 

 → Primary
 → Suppl

FINAL PROOF SURVEY
UNDER

R-39071 R-3425
 Application No. 39072 Permit No. 28983...
 IN NAME OF

PAUL N. & DOROTHY J. AUBERT

Surveyed May 10 1978, by W. A. Applegate