


T23S. R32½E. WM.

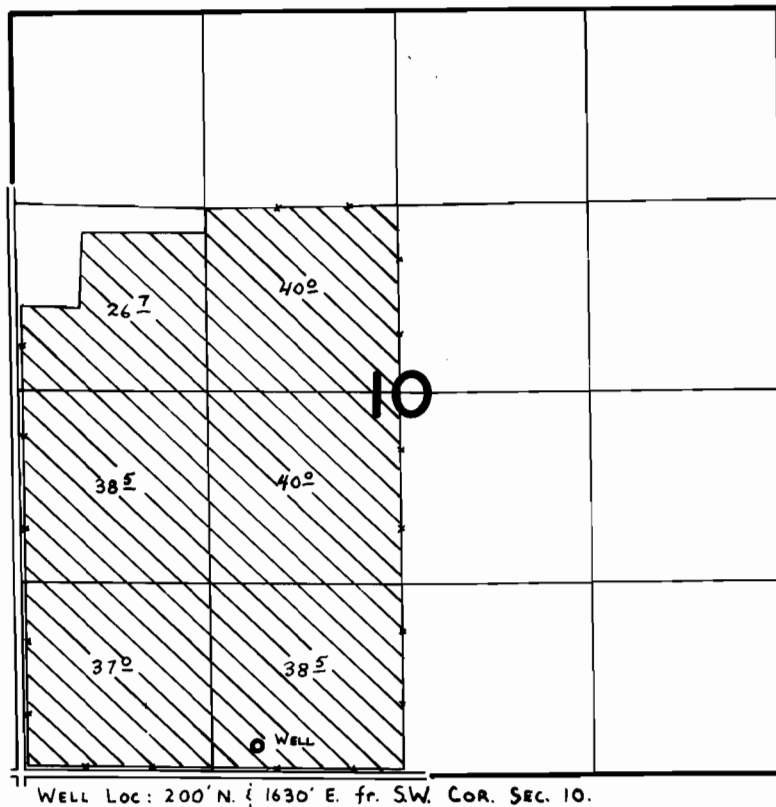

FINAL PROOF SURVEY
UNDER

Application No. G-6901 Permit No. G-6429
IN NAME OF

LESTER & HILDA TICE

Surveyed AUG. 29 1978, by C. L. HUGHES