


T. 34S., R. 31E., W.M.

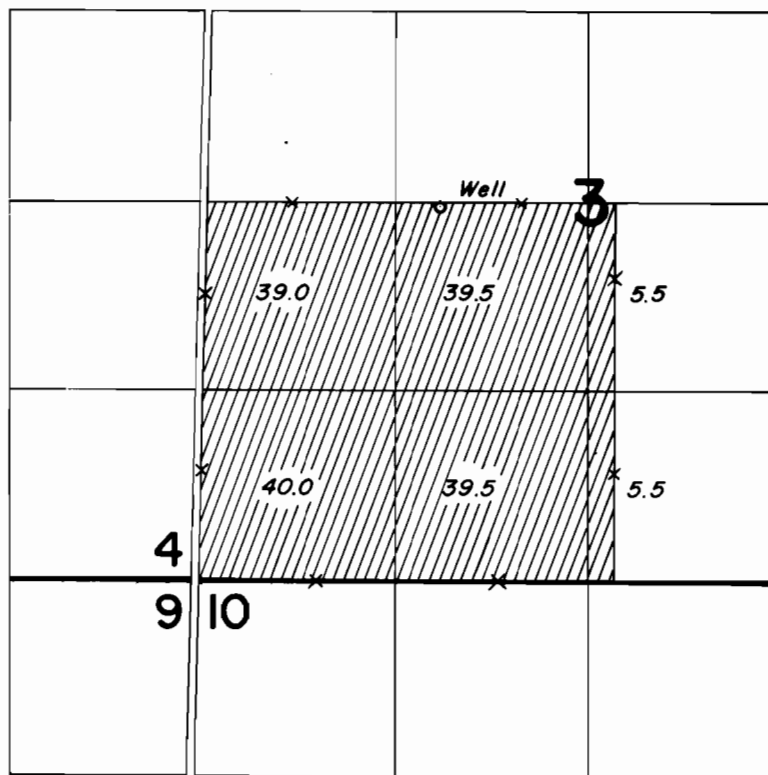

Well Loc.: 10' S. & 1620' E. From W. 1/4 Cor. Section 3

FINAL PROOF SURVEY
UNDER

Application No. G-7183 Permit No. G-6615
IN NAME OF

REX CLEMENS

Surveyed AUG. 25, 1978, by R. G. MUCKEN