


T27S. R33E. WM.

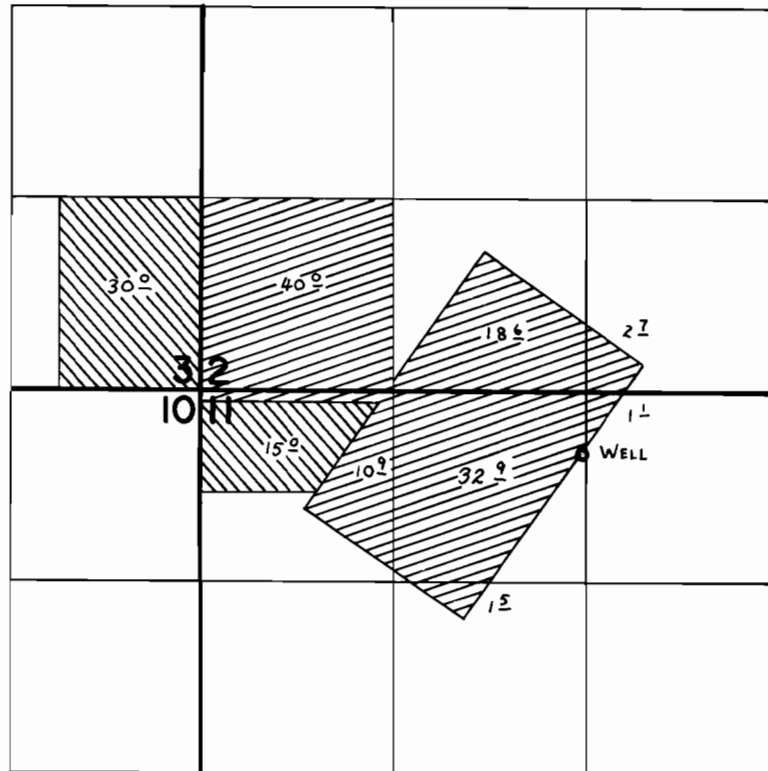

WELL LOC: 425' S. & 2625' E. fr. NW. COR. SEC. 11.

FINAL PROOF SURVEY
UNDER

Application No. G-8819 Permit No. G-8345
G-7407 G-6911
IN NAME OF

TOM C. DAVIES

Surveyed AUG. 30 1978, by C. L. HUGHES