


T23S. R30E. WM.

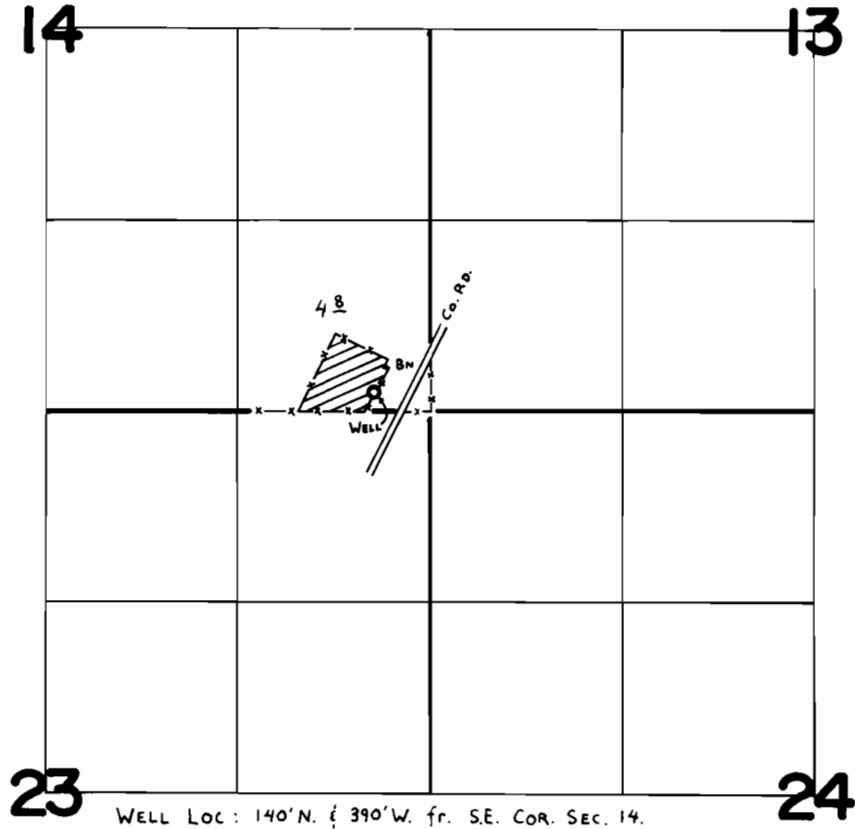

FINAL PROOF SURVEY
UNDER

Application No. G-7408 Permit No. G-6912
IN NAME OF

DAVID L. FRANZEN

Surveyed AUG. 31 1978, by C. L. HUGHES