


# T.39S.R.36E.W.M.

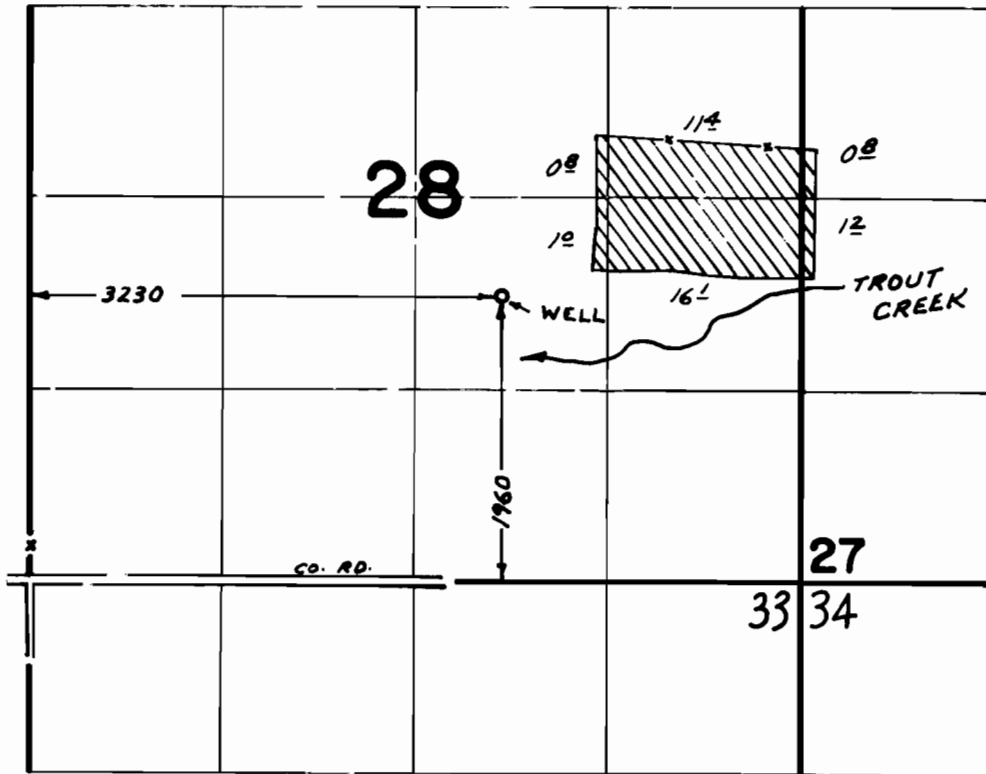

## FINAL PROOF SURVEY UNDER

Application No. G-8225 Permit No. G-7834  
IN NAME OF

MONTE D. SIEGNER

Surveyed AUG. 24 1978, by R. MUCKEN