


T22S. R32½E. WM.

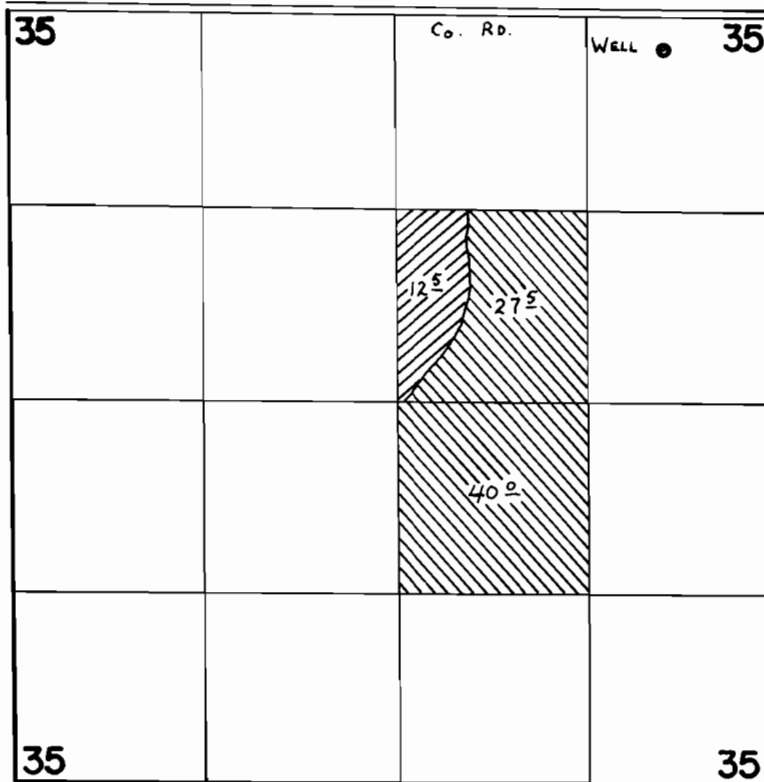

WELL Loc: 225' S. & 730' W. fr. N.E. COR. SEC. 35.

▨ - SUPPLEMENTAL IRRIGATION

▨ - PRIMARY IRRIGATION

FINAL PROOF SURVEY UNDER

Application No. G-8272 Permit No. G-7693
IN NAME OF

JACK G. & BONNIE J. SMITH

Surveyed AUG. 26 1978, by C. L. HUGHES