


T.22S. R.32 $\frac{1}{2}$ E. W.M.

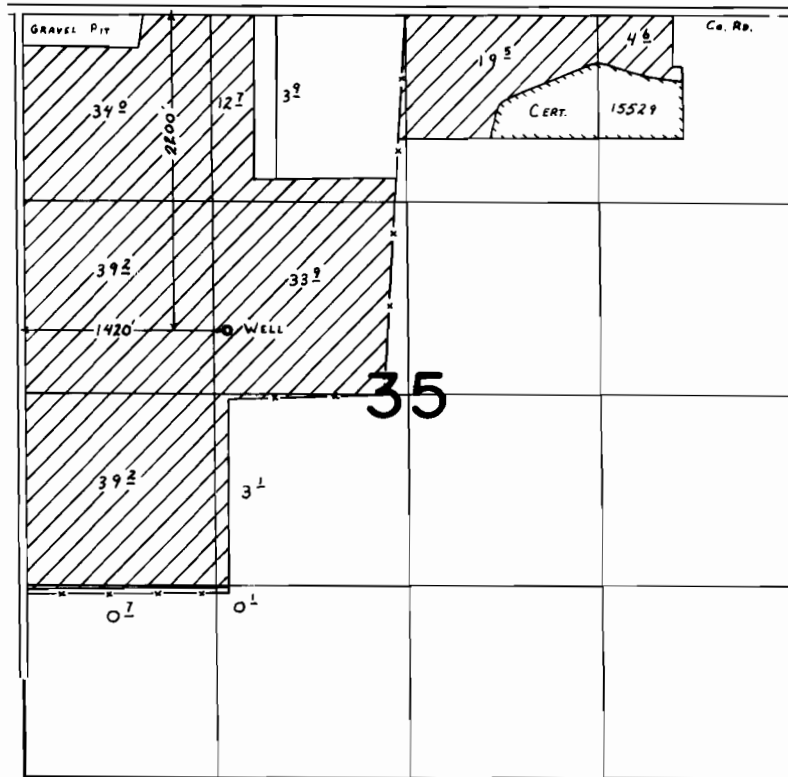

FINAL PROOF SURVEY
UNDER

Application No. G:8273. Permit No. G:7694....
IN NAME OF

JACK G. & BONNIE J. SMITH...

Surveyed Aug. 27... 1979, by R.G. Mucken.....