


T. 22S. R. 32E., W.M.

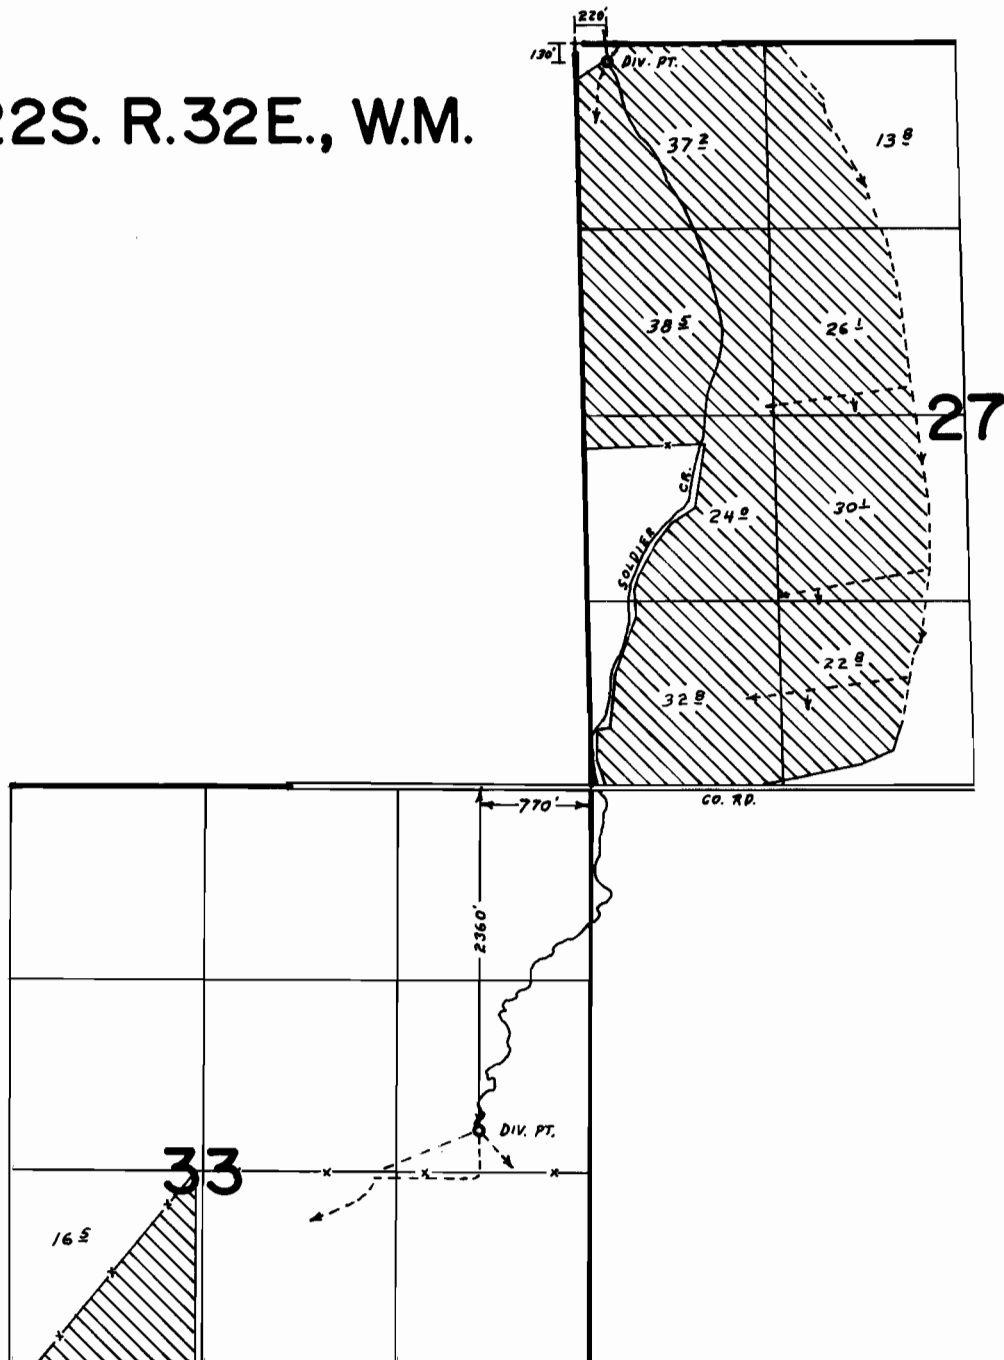

FINAL PROOF SURVEY
UNDER

Application No. 29122 Permit No. 22924
IN NAME OF

.....VOGLER.....

Surveyed JUL 29 1979, by R. G. MUCKEN.....