


T.23S. R.32 $\frac{1}{2}$ E., W.M.

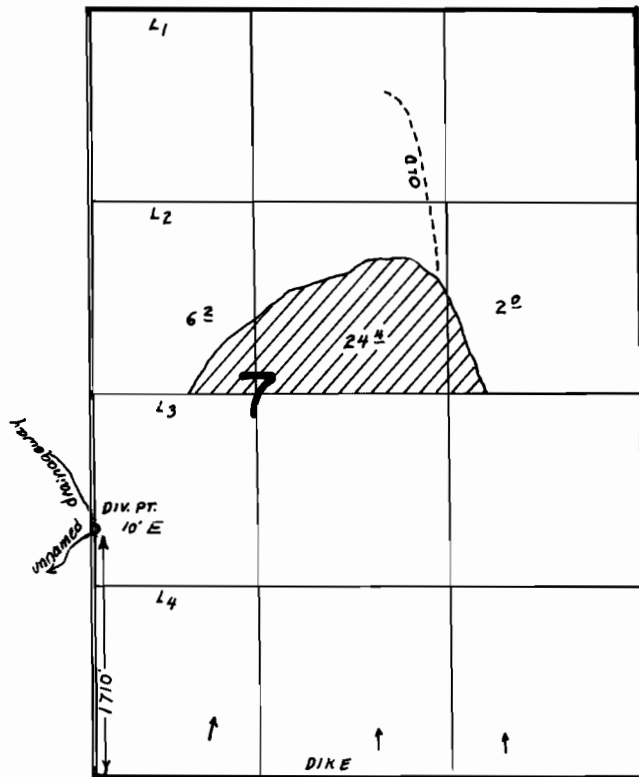

FINAL PROOF SURVEY
UNDER

Application No. 29123..... Permit No. 22925.....
IN NAME OF

.....VOGLER.....

Surveyed JUL 29... 1979., by R.G. MUCKEN.....