


9355  
5069

# Van Valkenberg Ditch

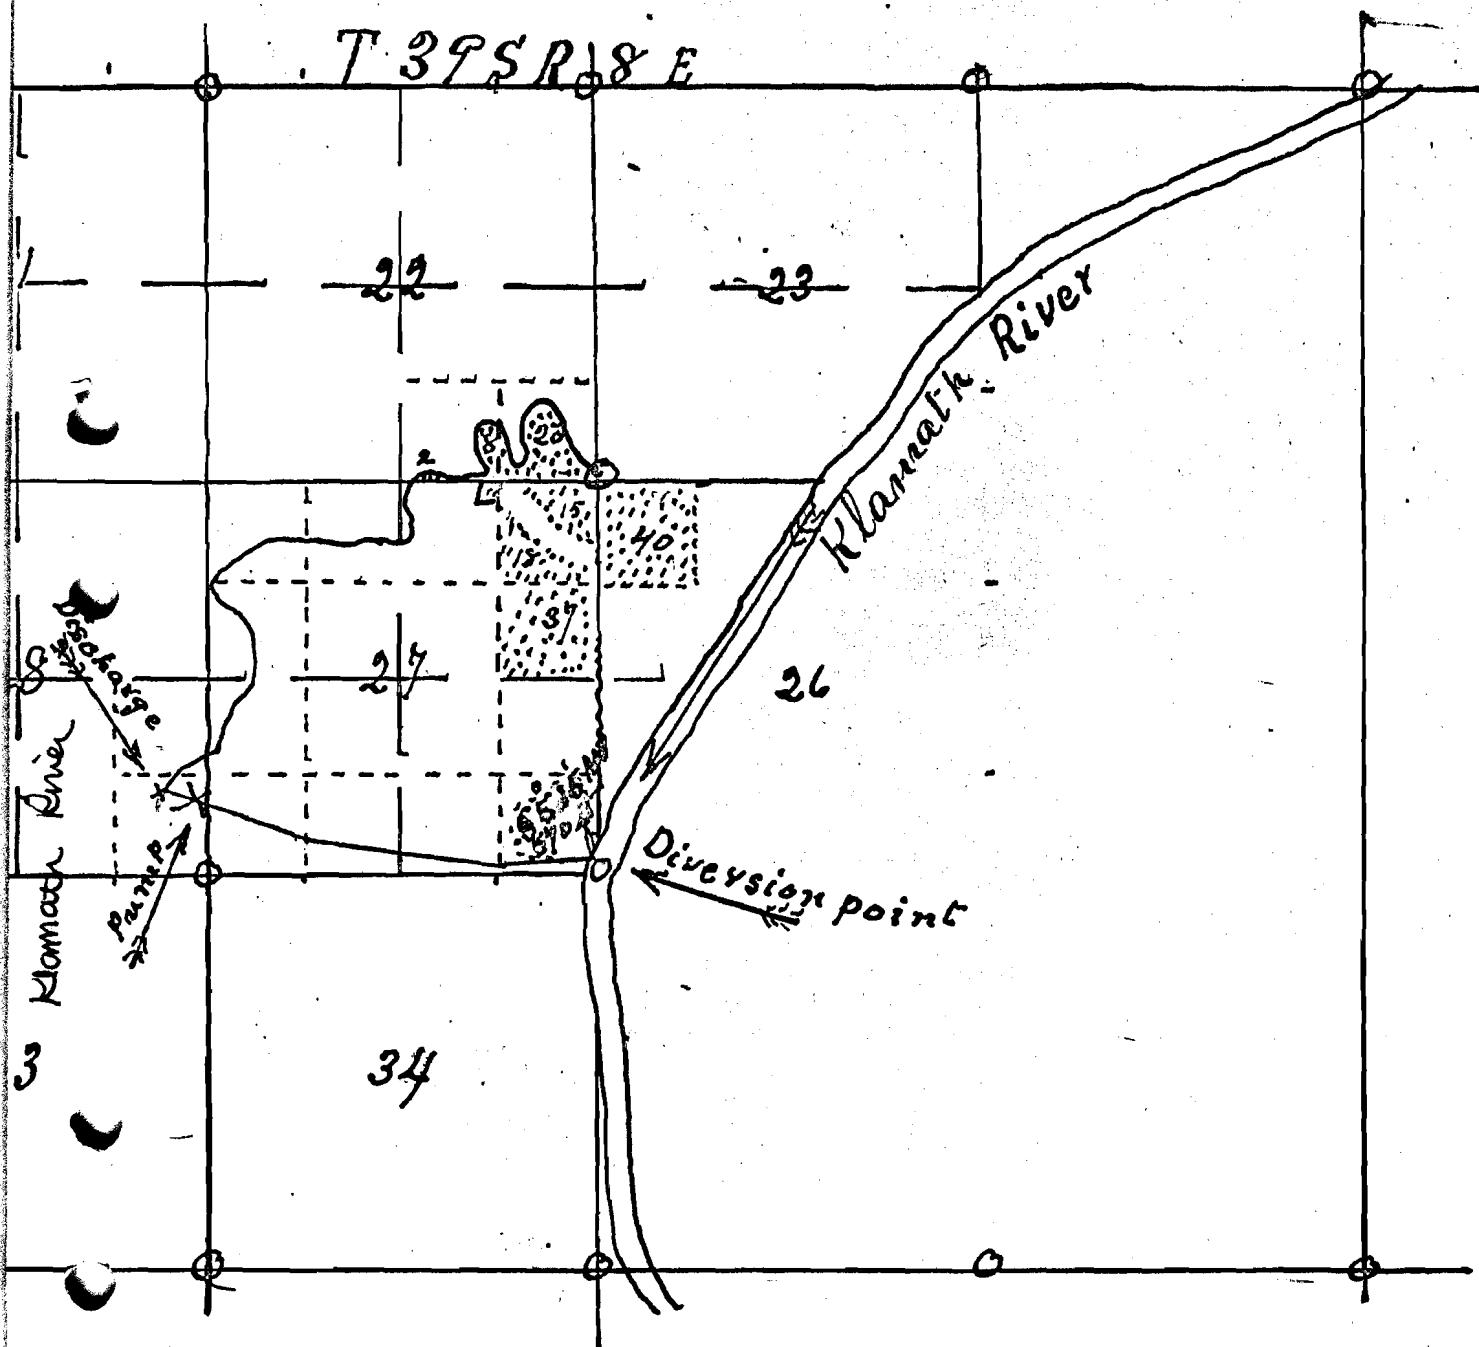

I R A Emmitt of Klamath Falls Oregon do hereby  
certify that this map was made from notes taken during  
actual Survey made by me on Nov 18<sup>th</sup> 1919 and  
it correctly represents the works described in the  
companying application together with the location  
streams and other ditches in the immediate vicinity  
I R A Emmitt  
Surveyor

Application No. 6958  
Permit No. 4355

OFFICE OF STATE ENGINEER