


TOWNSHIP 24 SOUTH, RANGES 31 & 32 EAST, W.M.

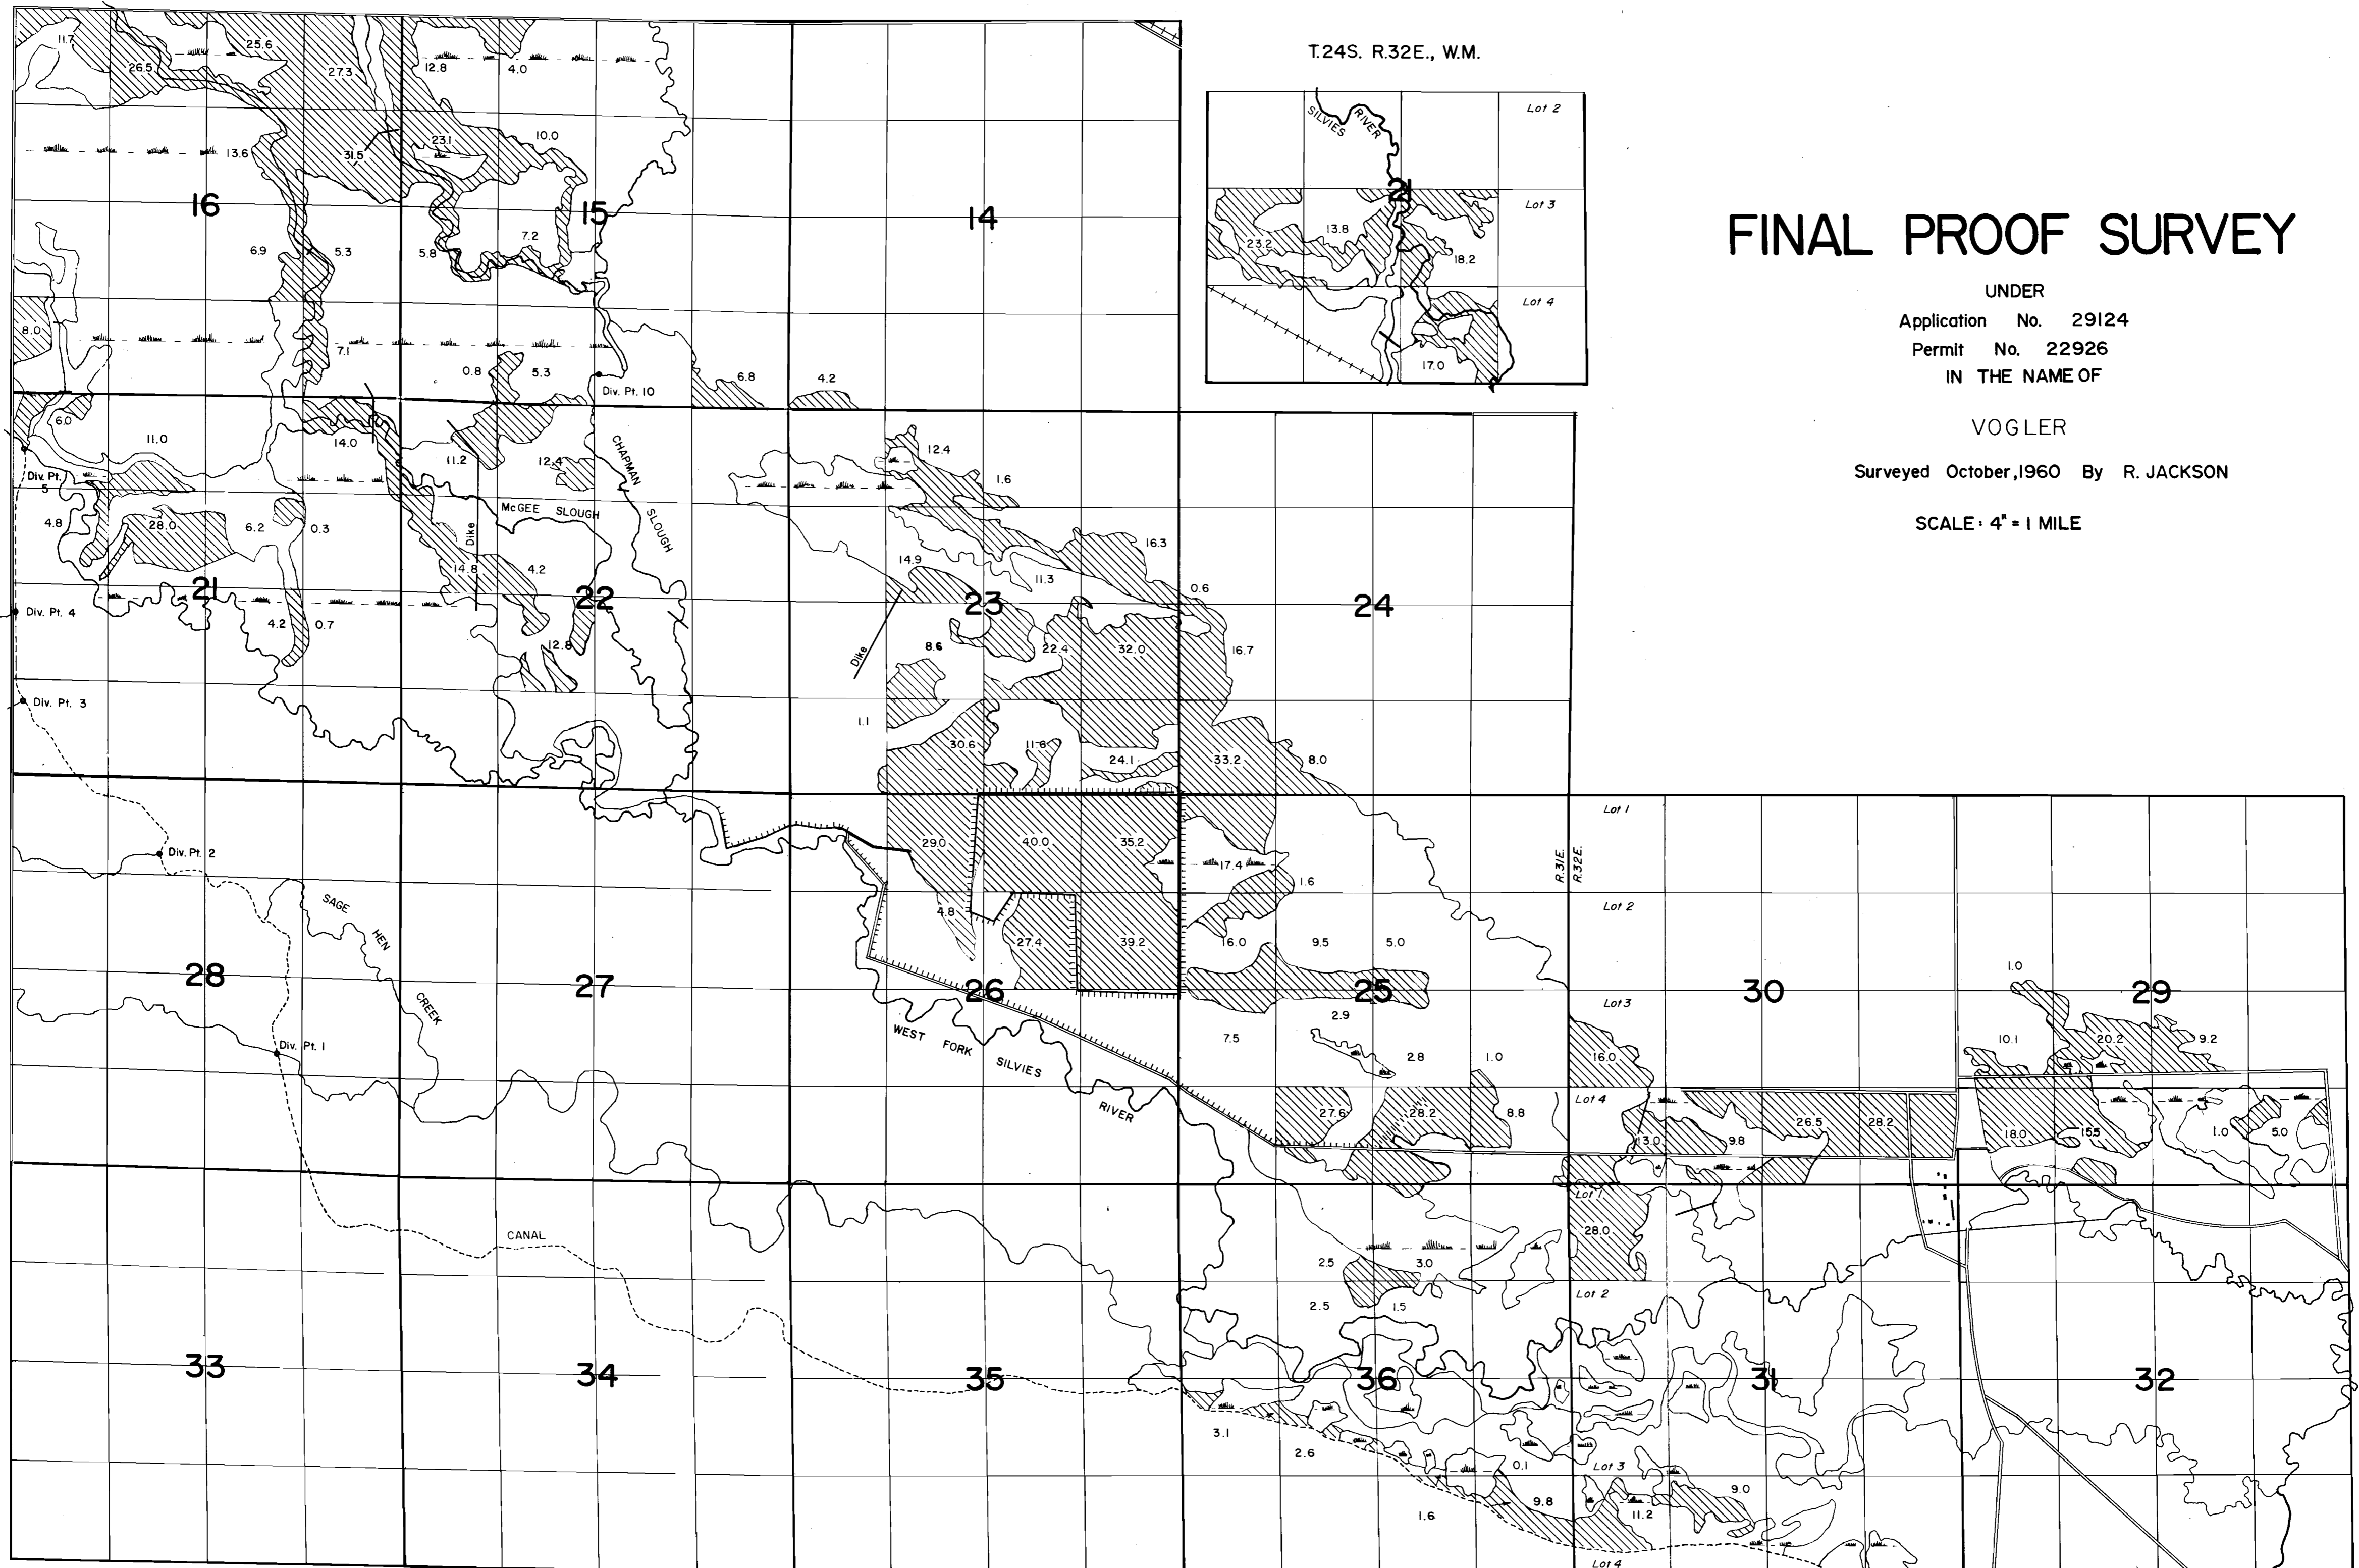

FINAL PROOF SURVEY

UNDER
 Application No. 29124
 Permit No. 22926
 IN THE NAME OF

VOGLER

Surveyed October, 1960 By R. JACKSON

SCALE 4" = 1 MILE

SAGE