


T.23S. R.32½E., W.M.

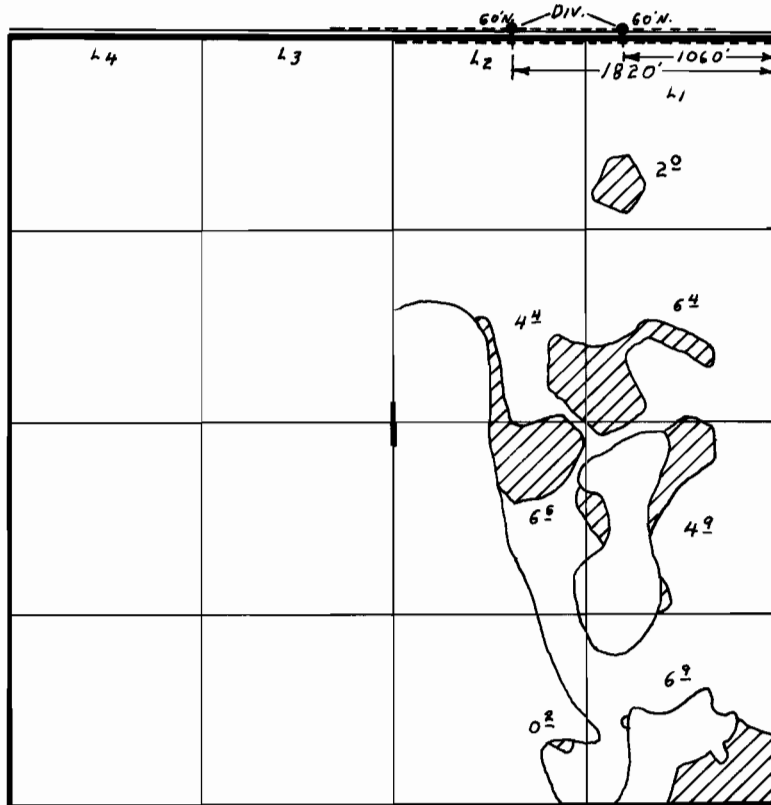

Existing Rights Under Cow Cr. Adjudication

FINAL PROOF SURVEY UNDER

Application No. 29125..... Permit No. 22927.....
IN NAME OF

.....*Y.O.GLER*.....

Surveyed JUL...31..... 1979., by R.G.MUCKEN.....