


T.33 S., R.1 E., W.M.

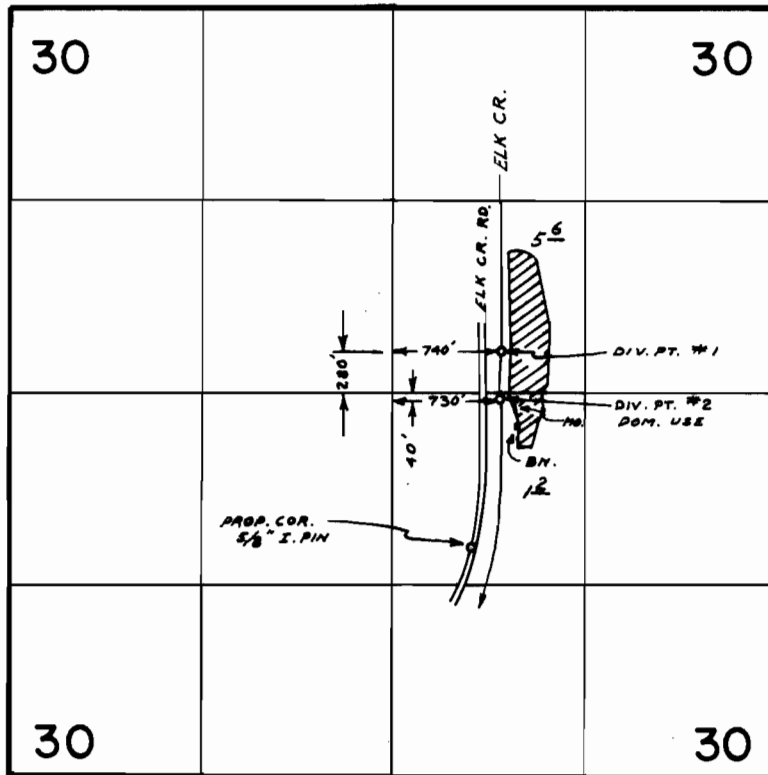

FINAL PROOF SURVEY UNDER

50656 38270
Application No. 43726 Permit No. 32684

IN NAME OF

CHARLES E. PITTS

Surveyed AUG. 29 1978, by B. SUND