


T.34 & 35 S., R.6 W., W.M.

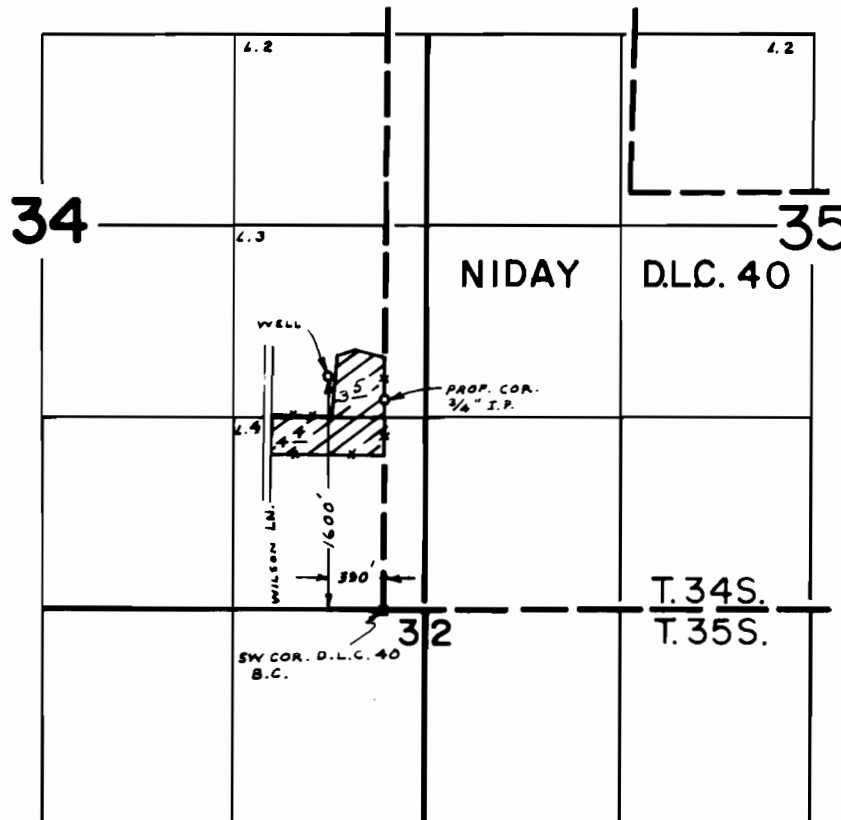

FINAL PROOF SURVEY
UNDER

Application No. G-5867 Permit No. G-5599
IN NAME OF

RICHARD WHITEHEAD

Surveyed JUN. 26 1978, by B. SUND