


T. 38 S. R. 7 & 8 W. W.M.

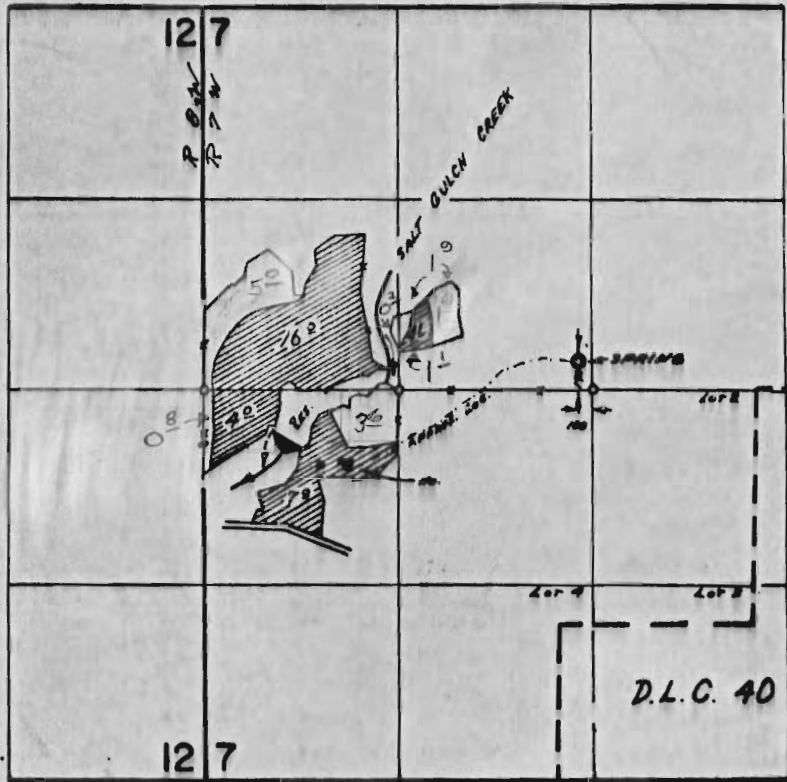

Div. Pt. Loc: 360' S. & 670' E from SW Cor. Sec. 9

FINAL PROOF SURVEY
UNDER

Application No. R-41470 41392 15235 Permit No. R 4608 30263 33793
IN NAME OF

CHARLES S. MOORE

Surveyed Apr 17 1970 by D. R. BUELL

782
1970