


RECEIVED

APR 28 1982

WM. DIST. 14  
GRANTS PASS, ORG

T. 38 S., R. 7 & 8 W., W.M.

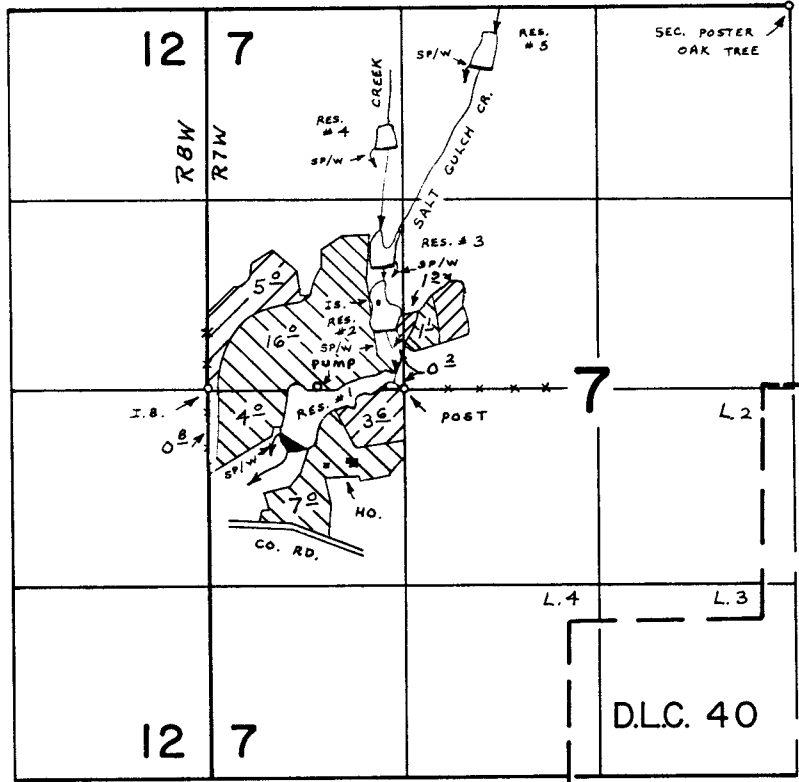

DIV. PTS. LOC.: RES. # 1 - 360'S. & 570'E., # 2 - 400'N. & 1220'E., # 3 - 870'N. & 1200'E., # 4 - 1660'N. & 1240'E., # 5 - 2200'N. & 1860'E., ALL FROM W. 1/4 COR., SEC. 7.

### FINAL PROOF SURVEY

UNDER

R-52619

R-6320

R-53637

R-6344

52653

39459

Application No. 53450... Permit No. 39597...

IN NAME OF

▨ SUPPL. ▨ PRIMARY...  
▨ SUPPL.

*Tall Timber Ranch*

Surveyed SEPT. 26 1977, by B. SUND

D.H.M.

P.T.S. - 1977 - 14 - B  
& P.T.S. - 1970 - A