


277/2
50699

T.40S.R.15E.W.M.

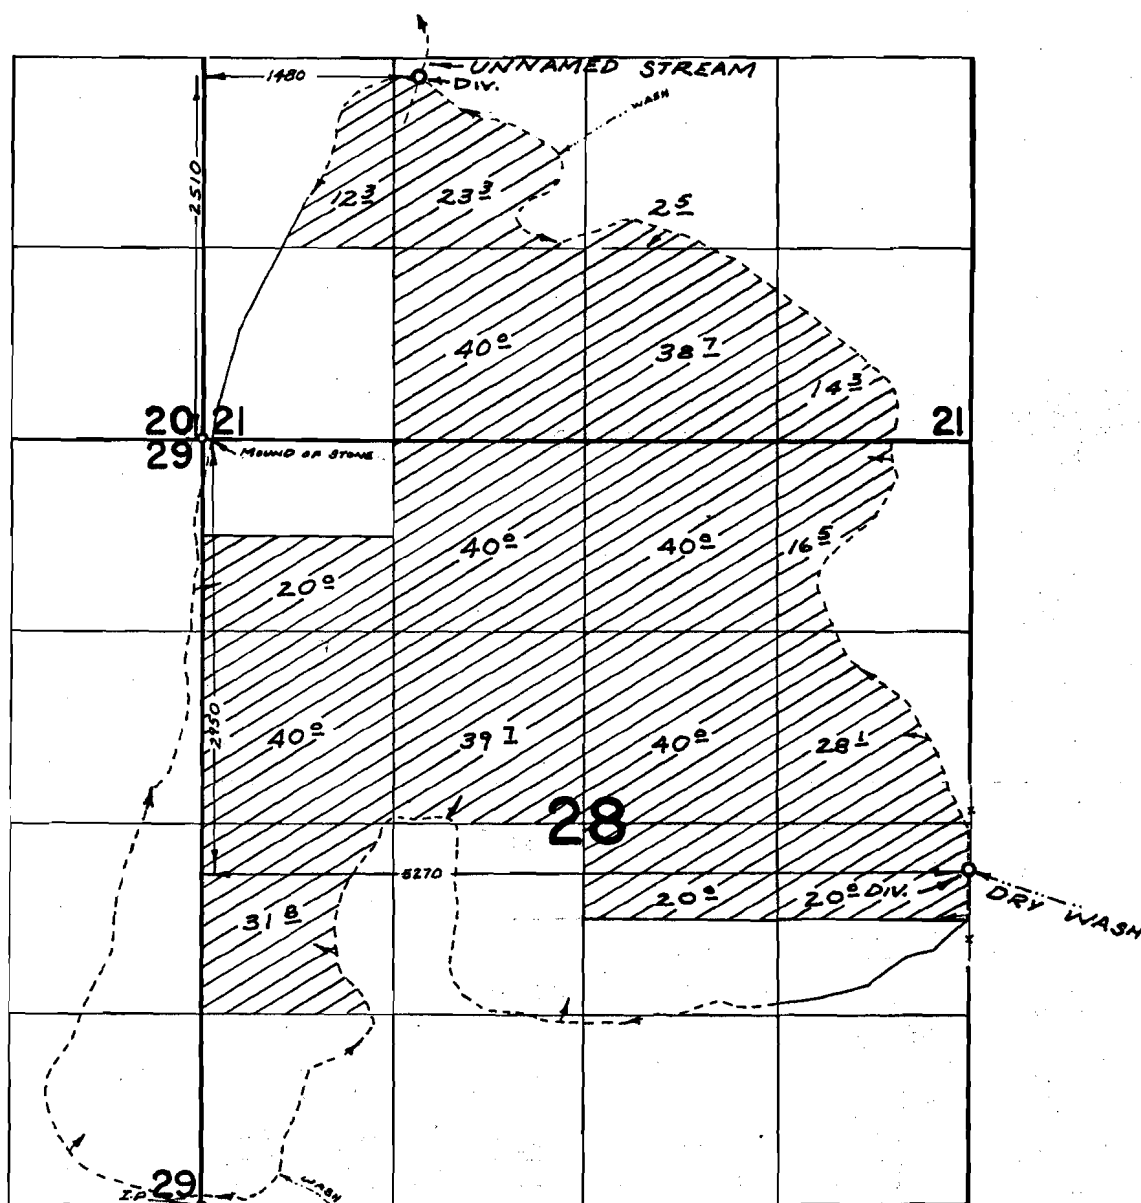

**FINAL PROOF SURVEY
UNDER**

Application No. 277/2 Permit No. 277/2
IN NAME OF

JOHNSON STOCK COMPANY

Surveyed SEPT. 16, 1971, by R. MURKIN.