


C-5670

Township No. 16 South, Range No. 18 East, Willamette Meridian.
Crook County, Oregon

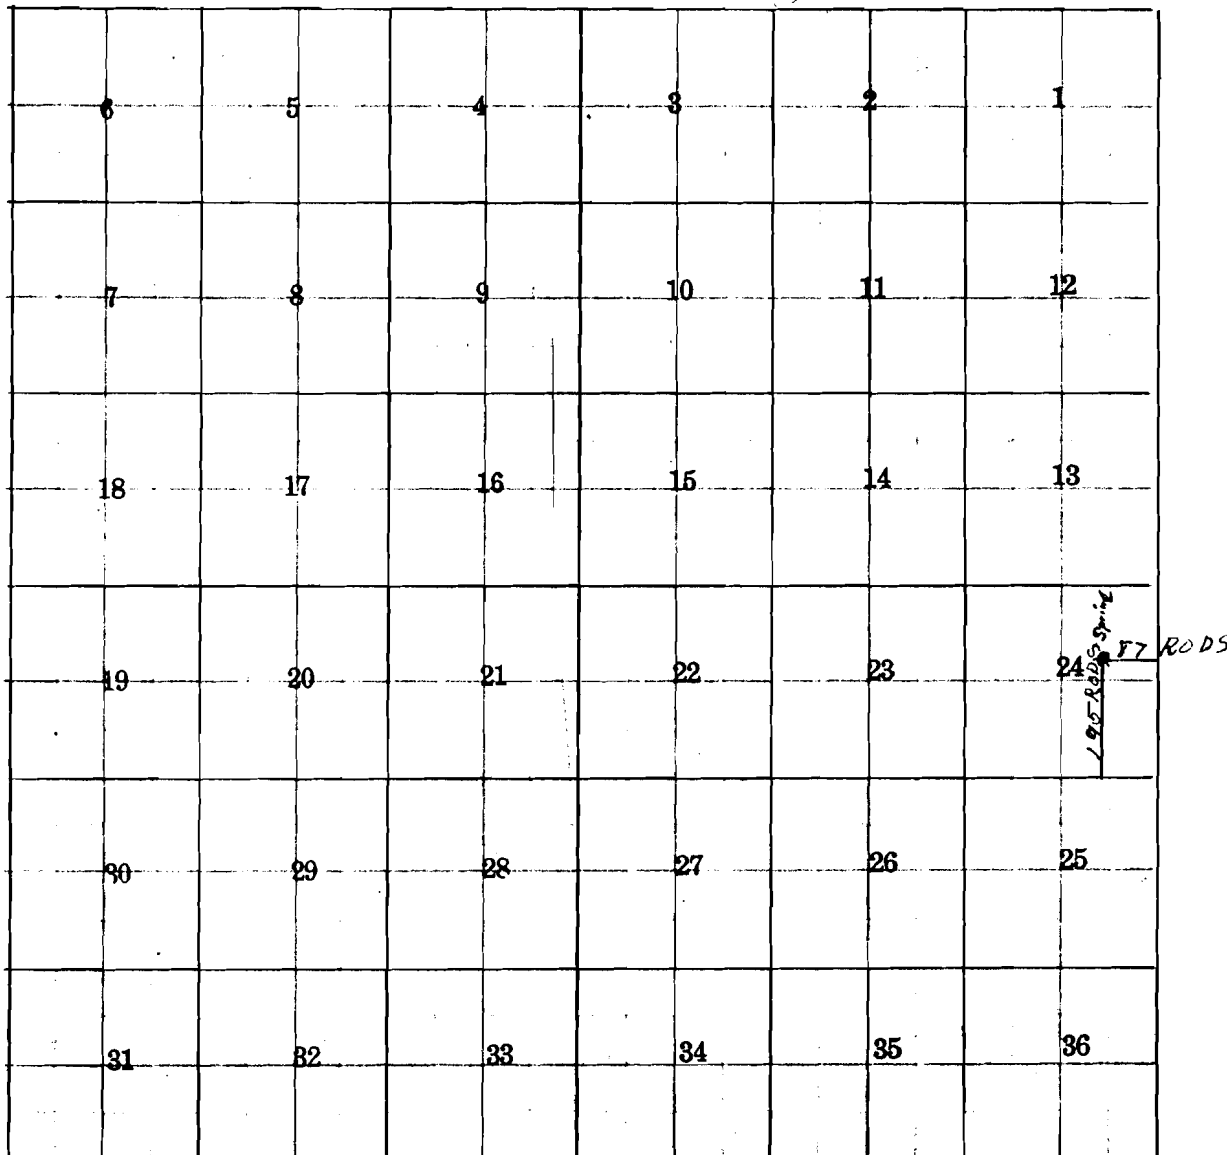

Map showing stock water filing of Albert L. Oldham, on a spring located at a point 195 rods north and 87 rods west of the southeast corner of Section 24, T 16 S., R. 18 E,

OFFICE OF STATE ENGINEER

RECEIVED
 APR 5 1920
 S. L. M. OREGON

Application No. 7194
 Permit No. 4530

4,220