


G 7208
50701

T39S. R19E. WM.

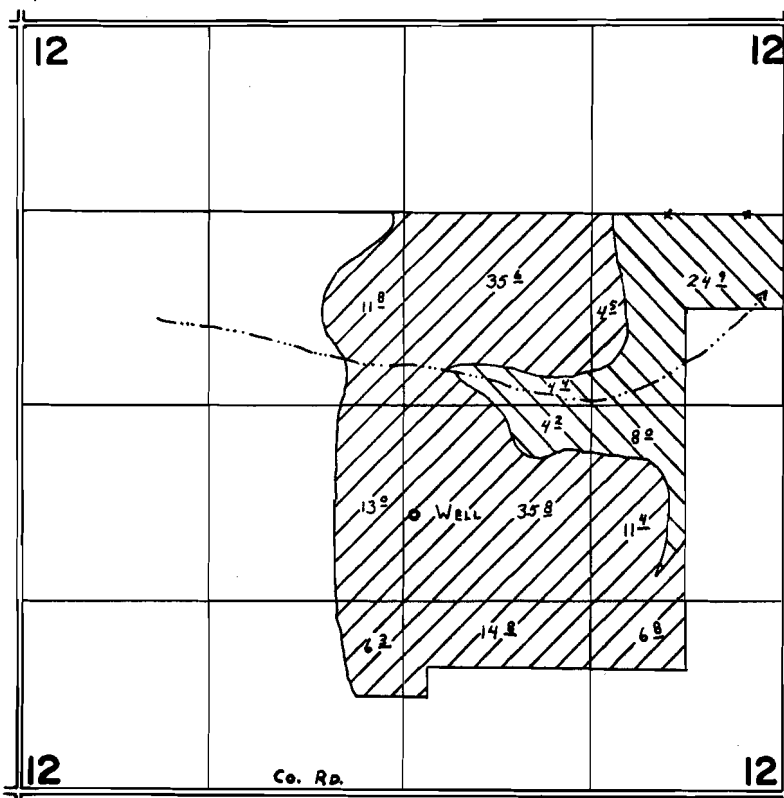

WELL LOC: 3380' S. & 2550' W. fr. NE Cor. Sec. 12.

- ▨ - SUPPLEMENTAL IRRIGATION
- ▩ - PRIMARY IRRIGATION

FINAL PROOF SURVEY UNDER

Application No. G-8159 Permit No. G-7208
IN NAME OF

LEEHMANN & SONS INC.

Surveyed JUNE 24 1978, by C. L. HUGHES