


T.21S. R.2W., W.M.

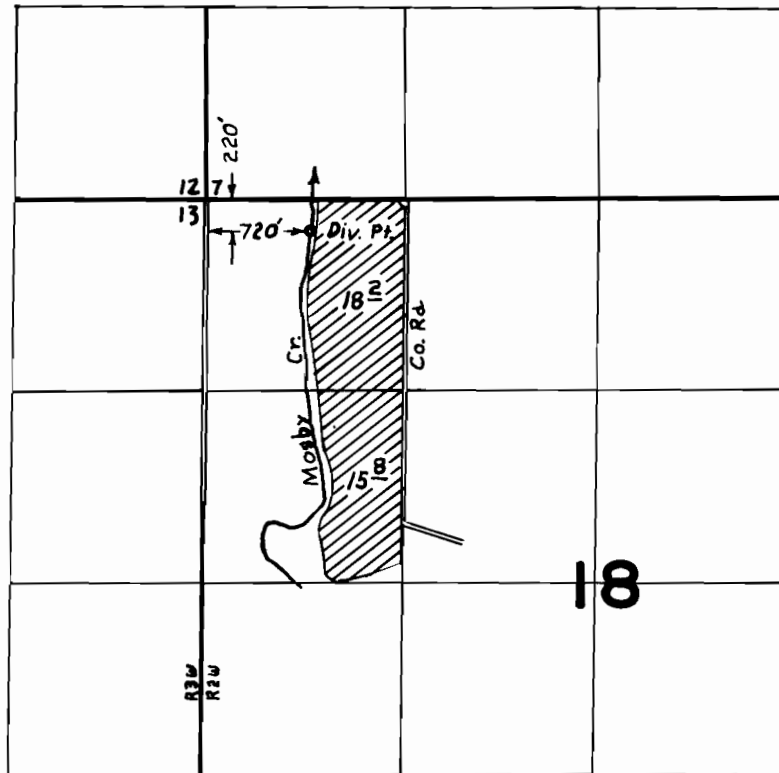

**FINAL PROOF SURVEY
UNDER**

Application No. 52387... Permit No. 39411.....
IN NAME OF

GEORGIA-PACIFIC CORPORATION

Surveyed MAR. 27. 1978., by J.S. DONALDSON