


T.13S.R.11W.W.M.

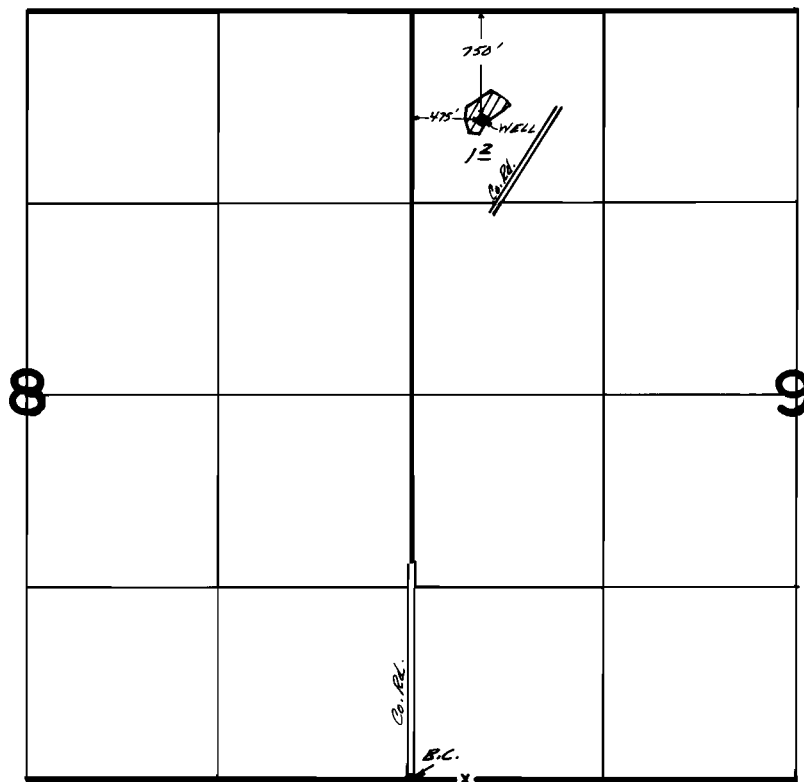

FINAL PROOF SURVEY
UNDER

Application No. G-5191 Permit No. G-5061
IN NAME OF

GEORGE L. GREEN

Surveyed Sept. 21, 1978, by J.S. Donaldson