


T. 12S. R. 11W. W.M.

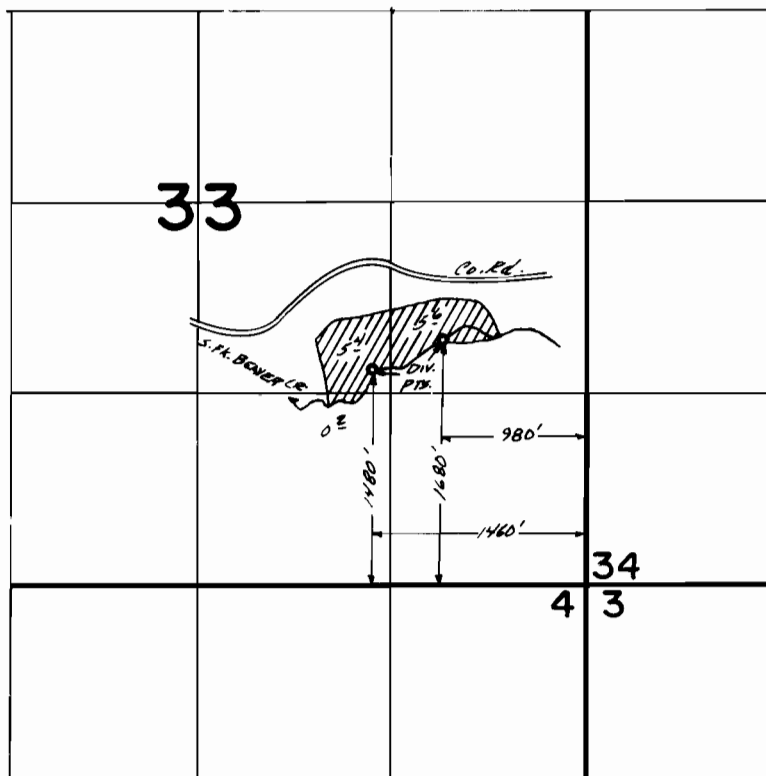

FINAL PROOF SURVEY
UNDER

Application No. 37126 Permit No. 27661
IN NAME OF

GEORGE L. LECHNER

Surveyed Sept. 20 1978, by J.S. Donaldson