



T. 5S. R. 1W. W.M.

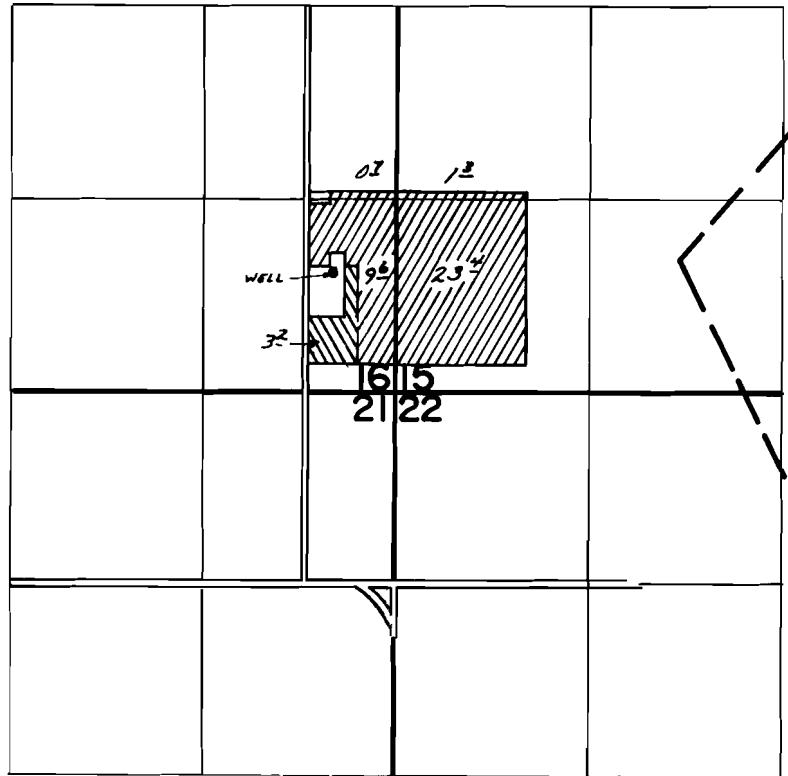

WELL LOC. - 810' N. & 410' W from SE COR. SEC. 16

 NOT ALLOWED
(NO PRIMARY)

FINAL PROOF SURVEY UNDER

Application No. G-5687. Permit No. G-5501...
IN NAME OF

FREDERICK LIVINGSTON PANTLE

Surveyed Aug. 15, 1978, by J.S. Donaldson