


T.4S. R.2W., W.M.

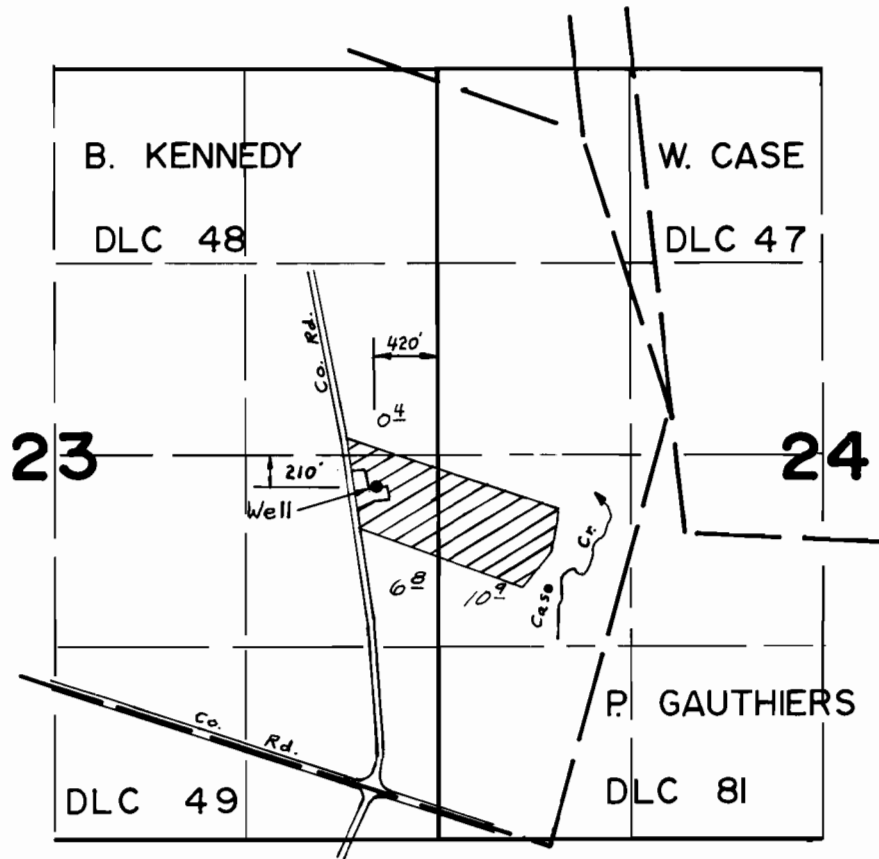

FINAL PROOF SURVEY UNDER

Application No. G-6421... Permit No. G-5226...
IN NAME OF

.....MAX G. SCHROEDER.....

Surveyed AUG. 15, 1977, by B. R. SUND.....
AUG 28, 1979 *[Signature]*