
## T. 6S. R.2W. W.M.

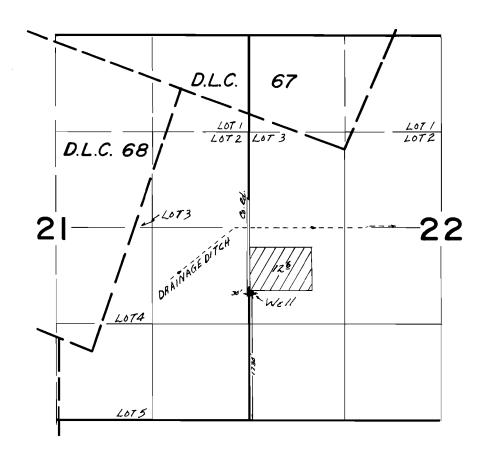

## FINAL PROOF SURVEY

| Application No. G.7237 Fermit No. G.6804 IN NAME OF |                        |
|---|------------------------|
| ERVIN KASPER  |                        |
| Surveyed Sept 5                                     | 1979. by C.R.RODRIGHEZ |