


G-6949

50710

15600
17452
18183
25705
50844

7-2847

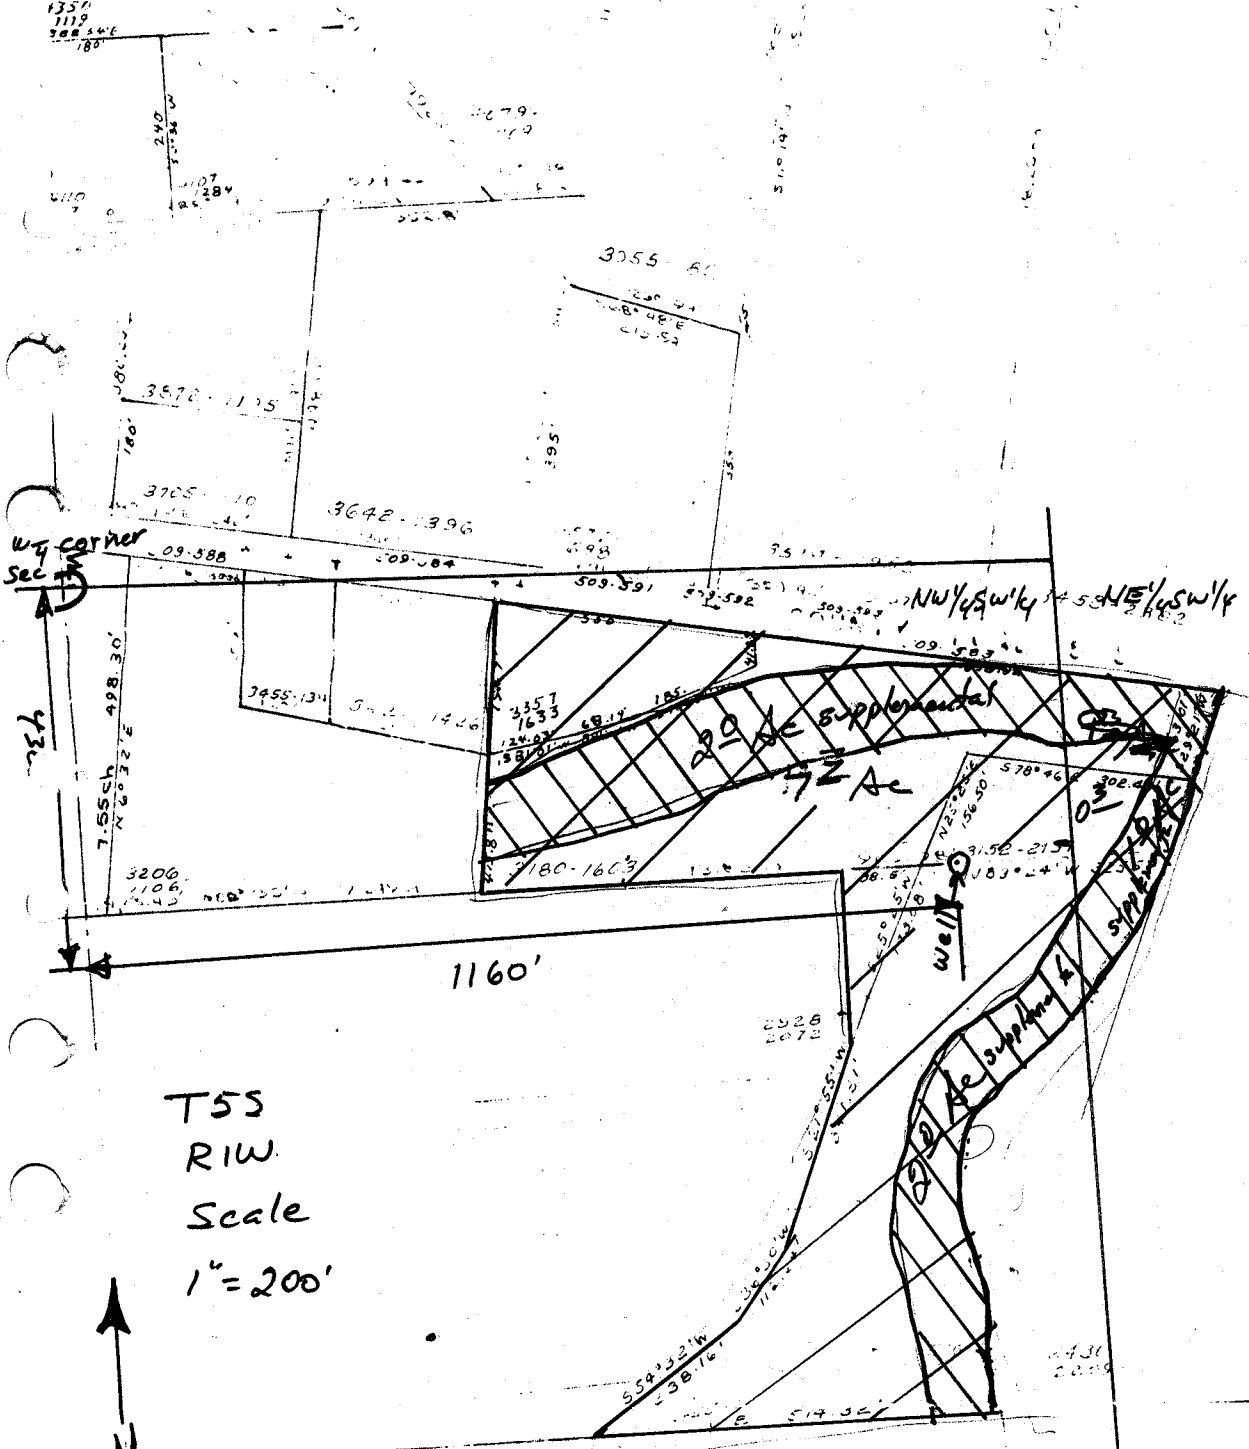

TSS
RIW
Scale
1" = 200'

Application No. G-7457
Permit No. G 6949

RECEIVED

JUL 29 1976

RESOURCES DEPT.

SIV RE-ENTRANT
COR E LINE
J CASEY CL

NW COR.
J COOLEY
LAND CL