


T. 5S.R. 1W.W.M.

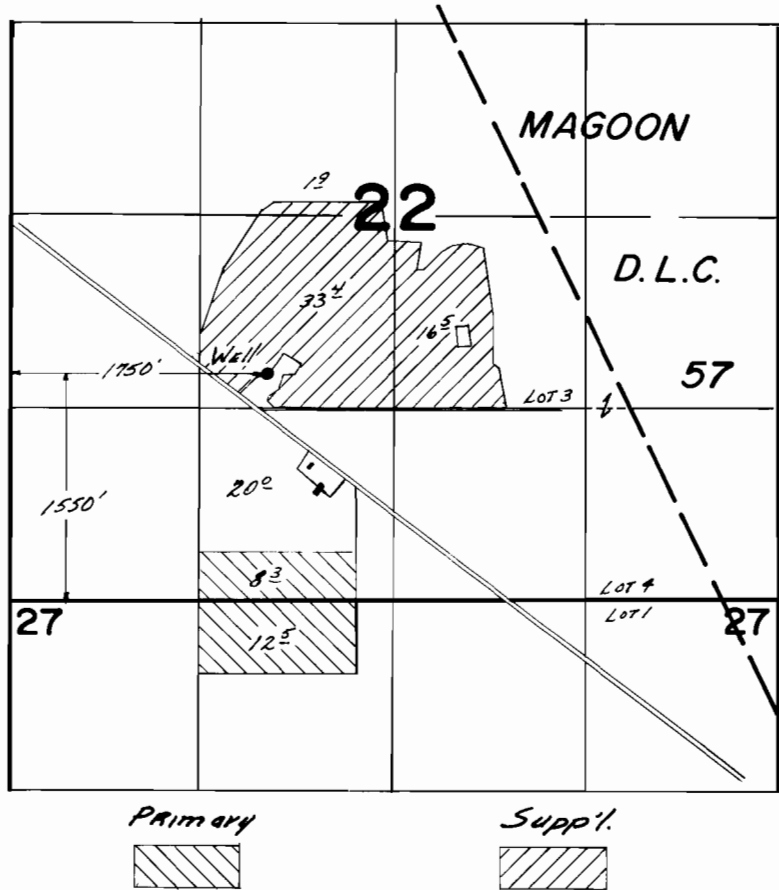

FINAL PROOF SURVEY UNDER

Application No. G-7.479 Permit No. G-7.260.
IN NAME OF

ELIZABETH HITZ

Surveyed Sept. 5, 1979, by C.R. RODRIGUEZ