


T. 6S., R. 18&2W., W.M.

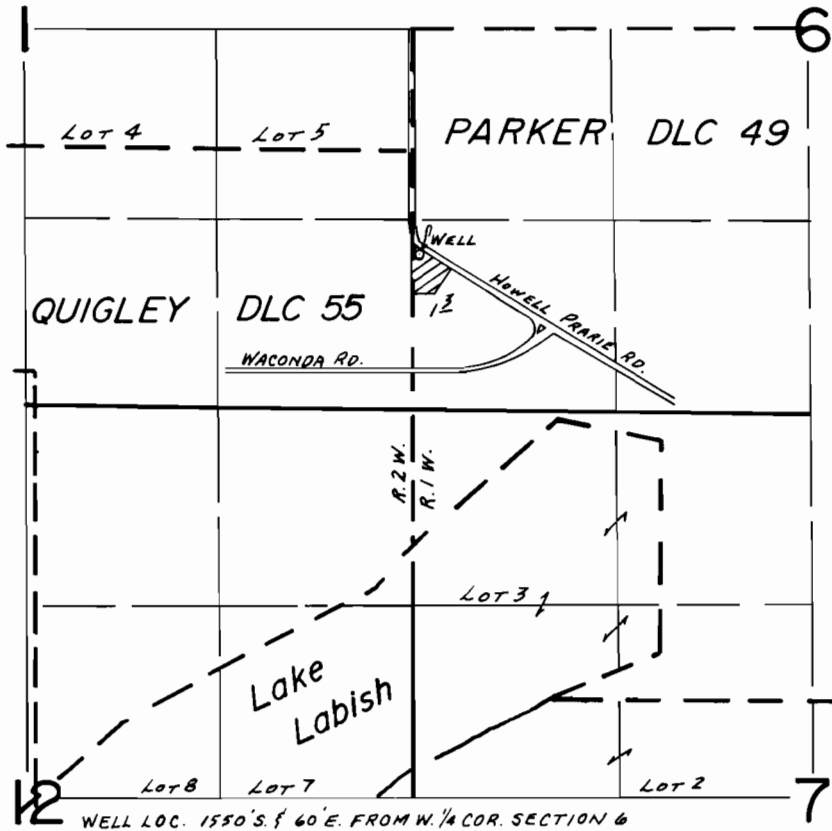

FINAL PROOF SURVEY
UNDER

Application No. G-7740 Permit No. G-7193.....
IN NAME OF

.....ELLA JEBOUSEK.....

Surveyed May 12.... 1980., by B.W. BISHOP.....