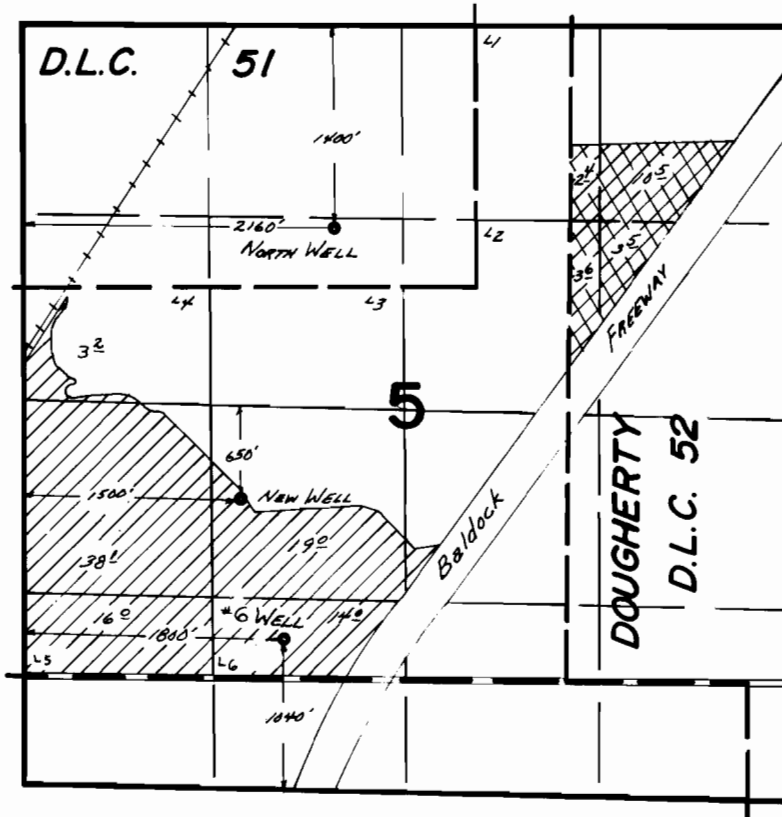

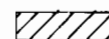


T.6S.R.2W.W.M.



-  - NORTH WELL
-  - NEW WELL

FINAL PROOF SURVEY UNDER

Application No. G-7894. Permit No. G-7302.
IN NAME OF

ERNEST L. ZIELINSKI

Surveyed Oct. 10, 1978, by J.S. Donaldson