


T.6S.R.2W. W.M.

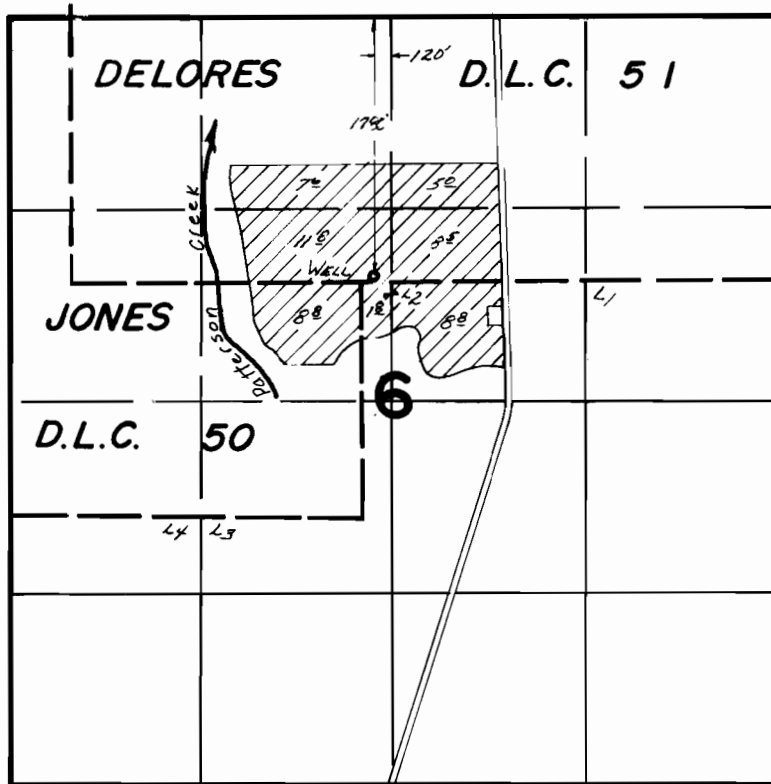

FINAL PROOF SURVEY UNDER

Application No. G-7.917. Permit No. G-7.728.
IN NAME OF

.....DOLORES ZIELINSKI.....

Surveyed Oct. 10, 1978., by J.S. Donaldson..