


T. 6S. R. 2W. W.M.

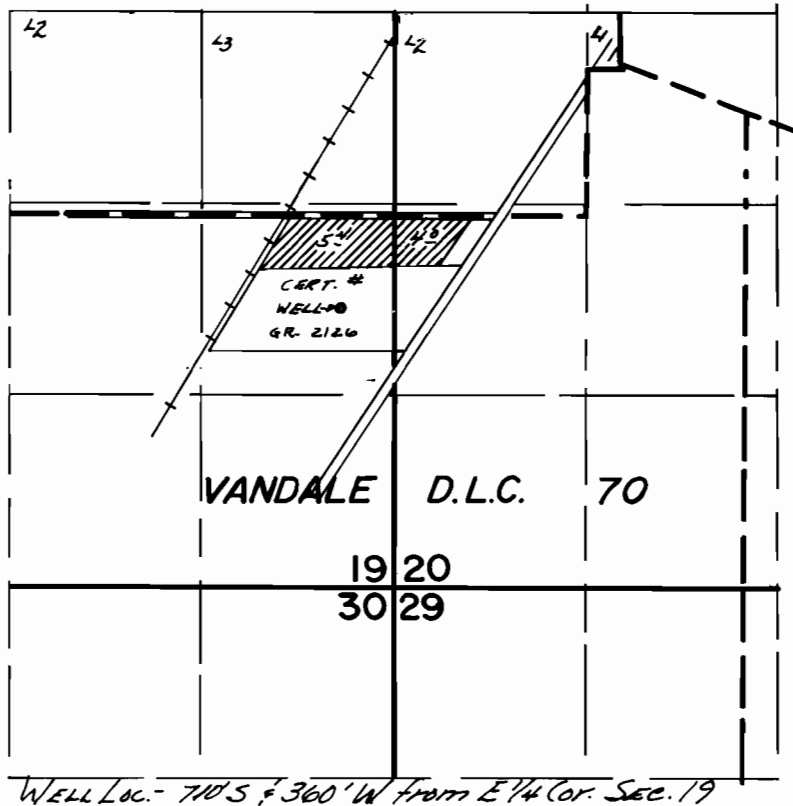

FINAL PROOF SURVEY UNDER

Application No. G-8101... Permit No. G-7486..

IN NAME OF
CHARLES D. HOLCOM &
CLARKSON "BILL" DUFFUS.....

Surveyed Oct. 10.. 1978., by J.S. Donaldson....