


Application No. G-8603
Permit No. G 7941

T.6S.,R.1W.,W.M.

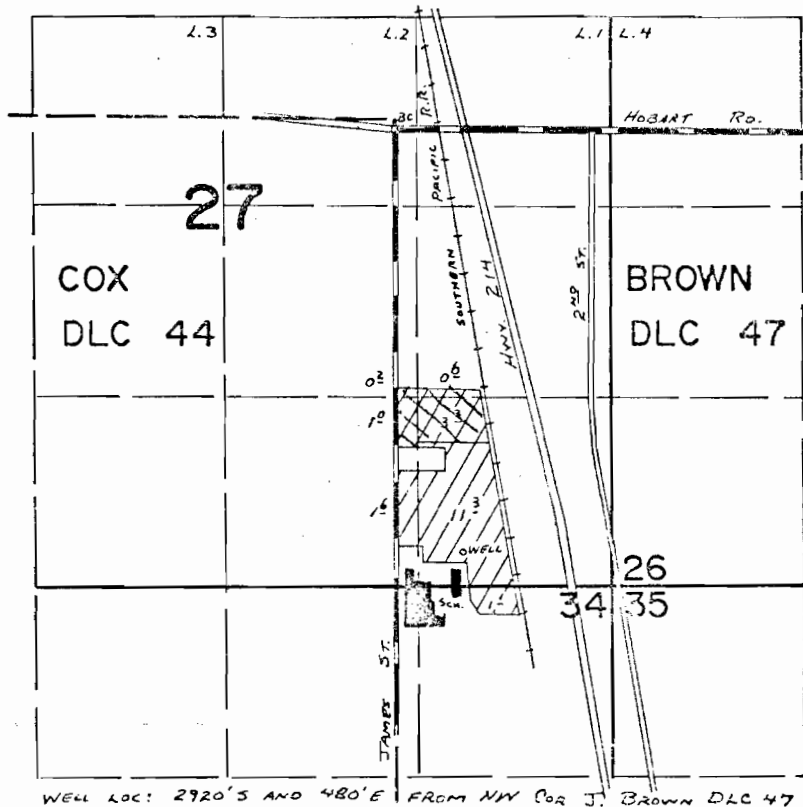

FINAL PROOF SURVEY
UNDER

Application No. G-5606 Permit No. G-5452.
IN NAME OF
SILVERTON UNION
HIGH SCHOOL DIST. "7-J"

Surveyed SEPT. 29 1975, by L. Toll