


# T. 4 S., R. 2 W., W.M.

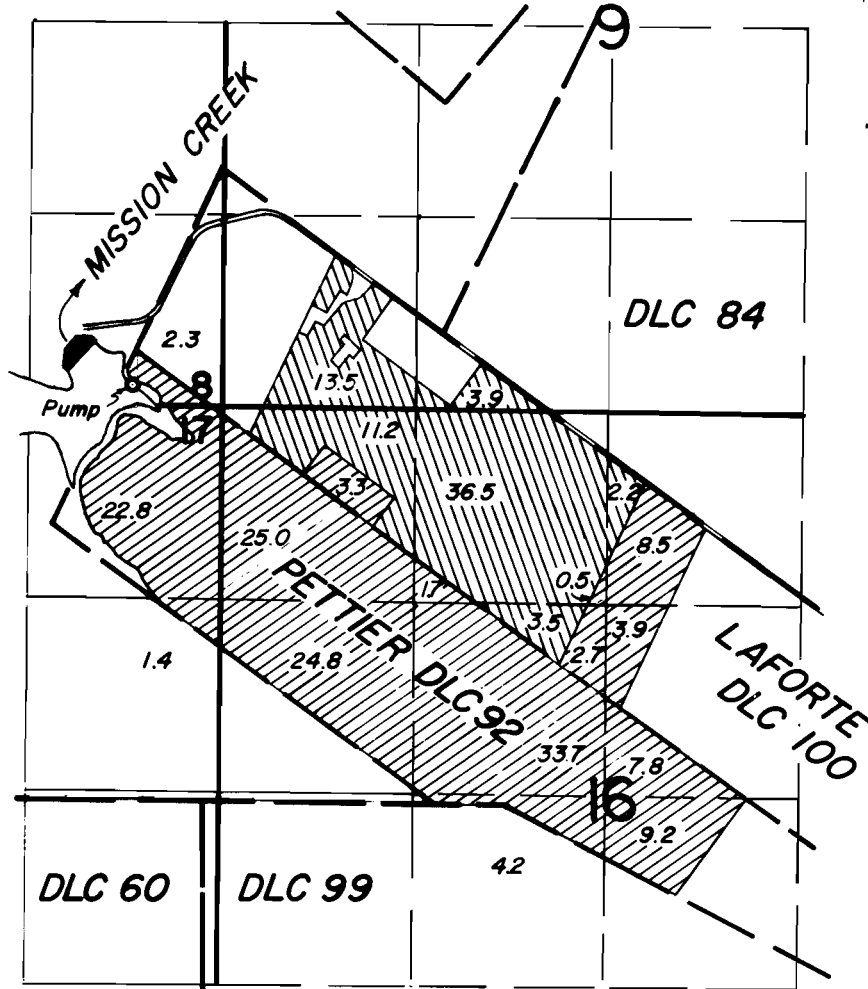

 PRIMARY  
 SUPPLEMENTAL TO GR-1810

## FINAL PROOF SURVEY UNDER

R-47860                      R-5667  
 Application No. 47861      Permit No. 35330  
 IN NAME OF

**DONALD & CLARA BUYSERIE**

Surveyed AUG. 17, 1977, by B. SUND