


T. 4 S., R. 2 W., W.M.

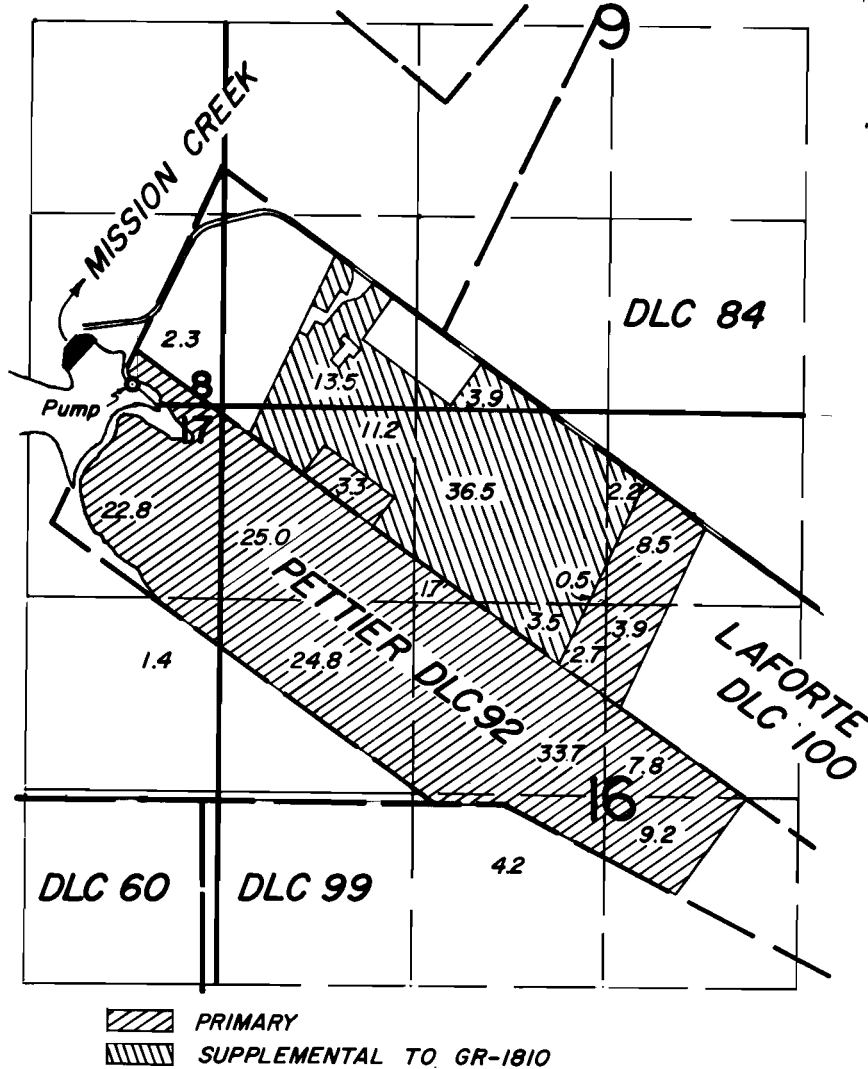

FINAL PROOF SURVEY UNDER

R-47860 R-5667
 Application No. 47861 Permit No. 35330
 IN NAME OF

DONALD & CLARA BUYSERIE

Surveyed AUG. 17, 1977, by B. SUND