


T. 9 S., R. 2 E., W.M.

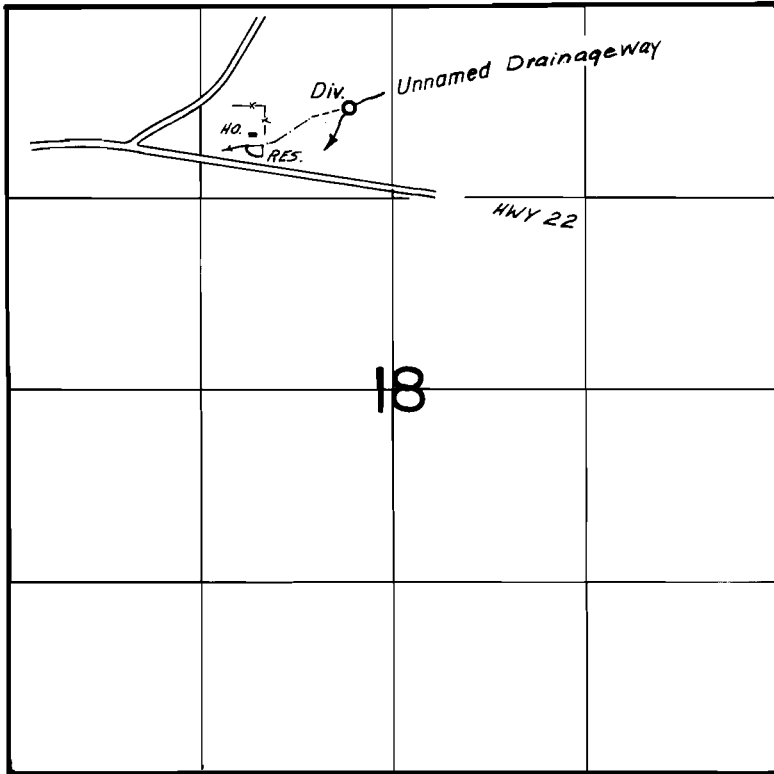

Div. Pt. Loc.: 700' S. & 290' W. from N. 1/4 Cor. Sec. 18

FINAL PROOF SURVEY

UNDER

Application No. *R-49226* *R-5990*
49227 Permit No. *36898*

IN NAME OF

Bruce J. Matthis

Surveyed *MAY 25*, 19*78*, by *S. APPLGATE*