


T. 9 S., R. 2 E., W.M.

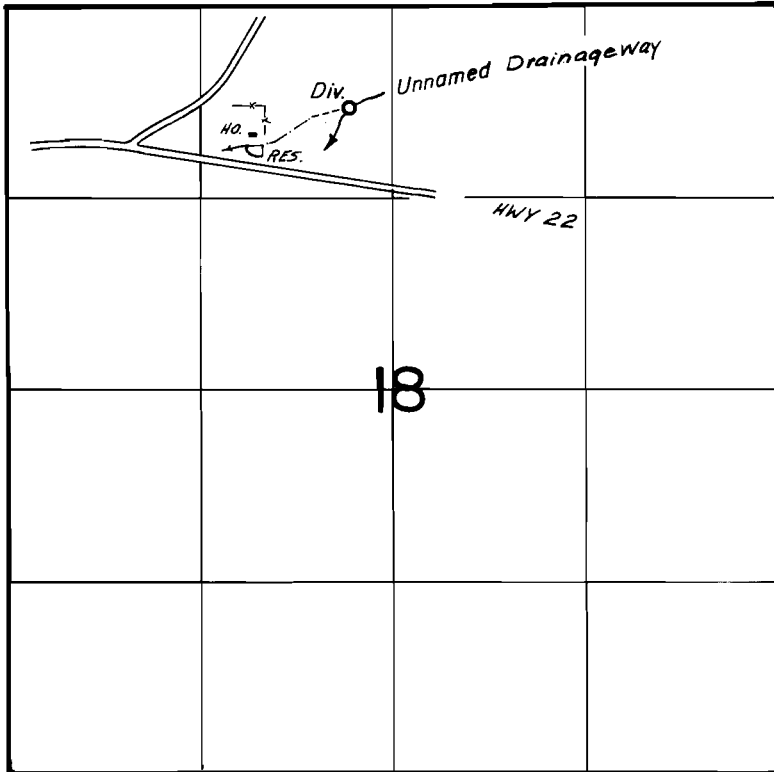

Div. Pt. Loc.: 700' S. & 290' W. from N. 1/4 Cor. Sec. 18

FINAL PROOF SURVEY

UNDER

Application No. R-49226 Permit No. R-5990
49227 36898

IN NAME OF

Bruce J. Matthis

Surveyed MAY 25, 1978, by S. APPLGATE