


T. 8 S., R. 3 & 4 W., W.M.

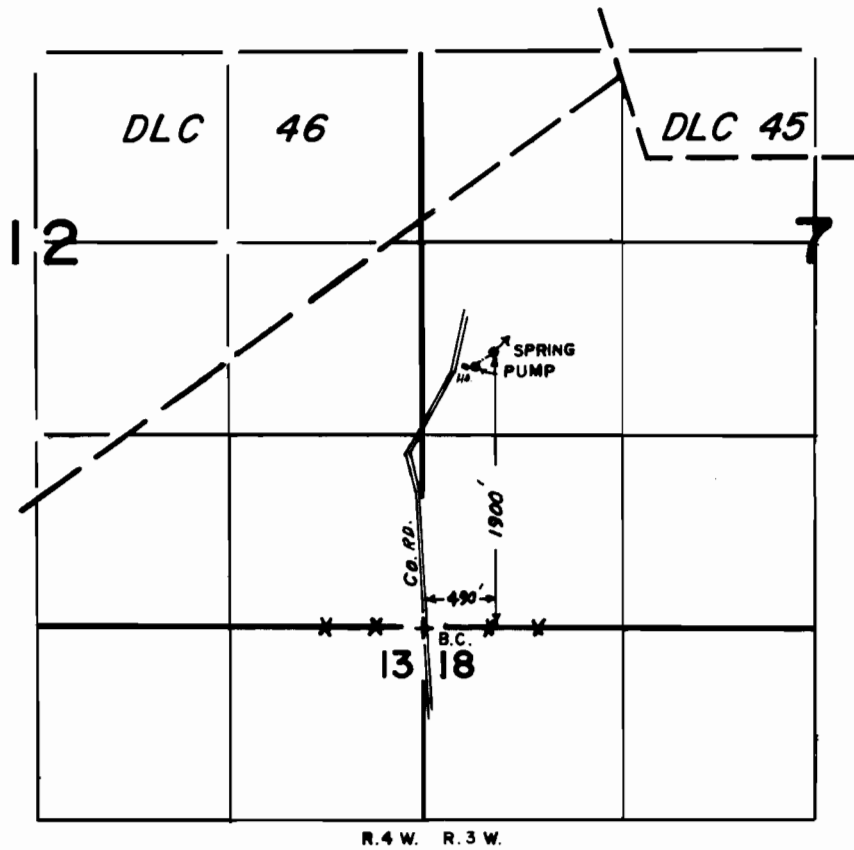

FINAL PROOF SURVEY
UNDER

Application No. 49304... Permit No. 36968....
IN NAME OF

CARL A. & PHYLLIS B. HALL.....

Surveyed OCT. 19. 1978, by S.P. APPLGATE