


T.38&4S.R.2W.W.M.

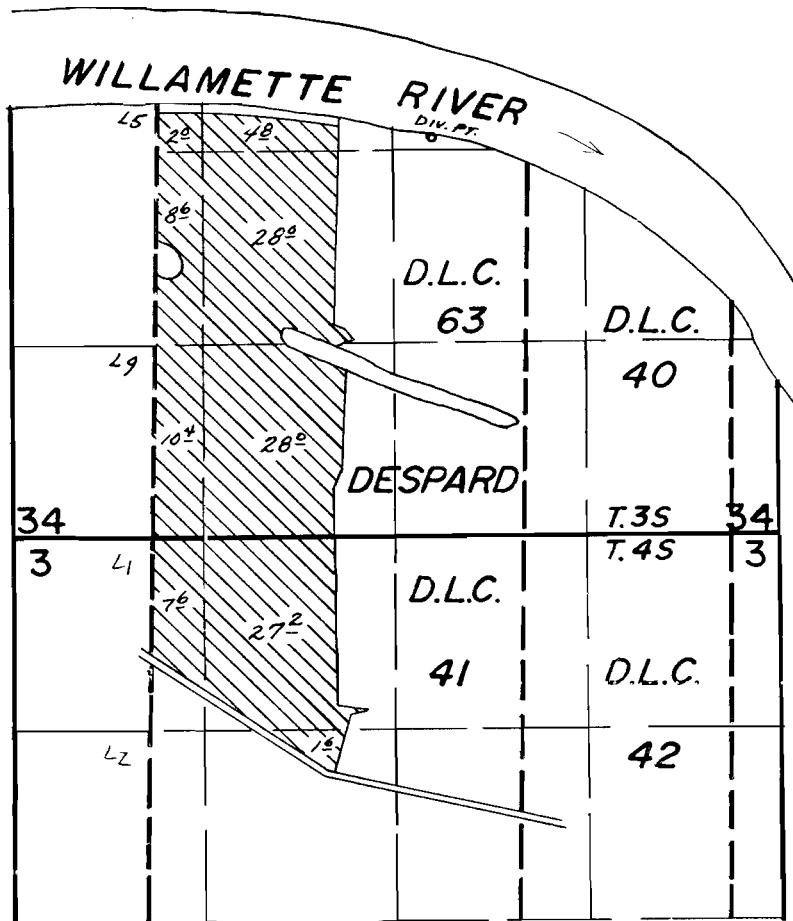

Div. Pt. Loc. - 2730' N. & 2900' E from SW Cor. Sec. 34

FINAL PROOF SURVEY UNDER

Application No. 50712... Permit No. 38302...
IN NAME OF

.....FRANK ABDERHALDEN.....

Surveyed Aug. 17, 1978, by J.S. Donaldson...